

MISSISSIPPI DEPARTMENT OF NATURAL RESOURCES

Bureau of Land and Water Resources

Southport Mall

P.O. Box 10631

Jackson, Mississippi 39209

WATER WELL DRILLERS LOG

Permit Applied For

Sunflower

J66-8874

Water Well

1988

Sunflower

4-4 date well completed

firm name

county well located

LANDOWNER:

Jimmy Shelton

description of formations encountered

Rt P Box 6

Shaw Ms. 38773

(mailing address)

Clay  
Fine Sand  
Sand & Gravel

from	to
0	28
28	58
58	105

WELL LOCATION:

127C sec. 5 T. 20 N R. 5 E 3 miles of Shaw (distance) (direction) (nearest town)


WELL PURPOSE:

Irrigation

(home, irrigation, municipal, industrial)

WELL COMPLETION DATA:

- (1) diameter (inches) 10"
- (2) total depth (feet) 105'
- (3) static water level (feet) \_\_\_\_\_ below above top of ground.
- (4) casing steel (material), (depth) \_\_\_\_\_ if telescope see back.
- (5) screen 40 (length), (depth to top) 10 (size), (material)
- (6) pump 30 (HP), 1500 (yield gpm) Gear (type power)
- (7) electric log No (yes or no) None (organization running log)
- (8) how well bottom plugged Plate

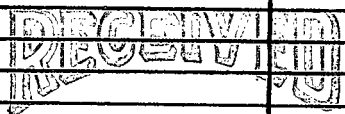


MAY 02 1988

Department of Natural Resources  
Bureau of Land & Water Resources

DRILLERS REMARKS:

If well telescopes please  
sketch and show depths.

GROUND LEVEL

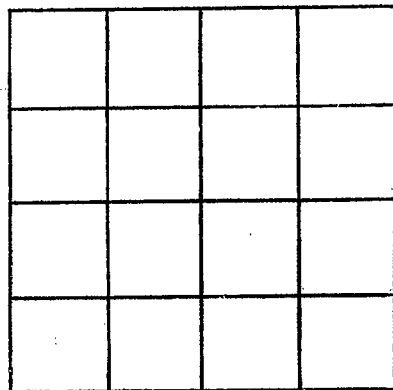

SECTION \_\_\_\_\_

Please indicate well location X.

ADDITIONAL INFORMATION

If more than one screen,  
show locations of each on sketch.