

MISSISSIPPI DEPARTMENT OF NATURAL RESOURCES

Bureau of Land and Water Resources

Southport Mall

P.O. Box 10631

Jackson, Mississippi 39209

WATER WELL DRILLERS LOG

Permit Applied For

Surveyor J. B. 673

4-4 date well completed

88 Day Well firm name

Sunflower county well located

LANDOWNER: Jimmy Shelton

Description of formations encountered

from

to

RT 4 Box 6
Shaw, Ms. 38773
(mailing address)

Clay	0	26
Fine Sand	26	95
Sand & Gravel	95	106
Fine Sand	106	115
Sand & Gravel	115	145

WELL LOCATION:

127c sec. 5 T 20 N R 5 S
3 miles E of Shaw
(distance) (direction) (nearest town)

WELL PURPOSE: Irrigation
(home, irrigation, municipal, industrial)

WELL COMPLETION DATA:

- (1) diameter (inches) 10"
- (2) total depth (feet) 145'
- (3) static water level (feet) _____ below above top of ground.
- (4) casing steel (material), (depth) 10" (size) if telescope see back.
- (5) screen 40 (length), (depth to top) 10 (size), (material)
- (6) pump 15 (HP), (yield gpm) Elec (type power)
- (7) electric log No (yes or no) None (organization running log)
- (8) how well bottom plugged Plates

RECEIVED


MAY 08 1968

MISSISSIPPI DEPARTMENT OF NATURAL RESOURCES
Bureau of Land and Water Resources

DRILLERS REMARKS:

If well telescopes please
sketch and show depths.

GROUND LEVEL

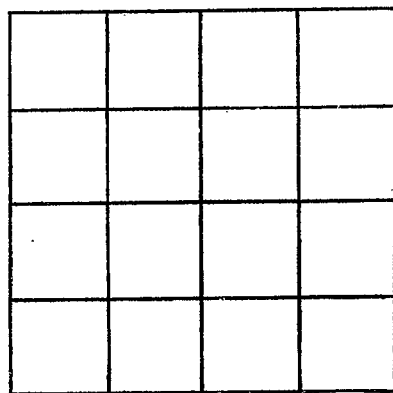

SECTION _____

Please indicate well location X.

ADDITIONAL INFORMATION

If more than one screen,
show locations of each on sketch.