

MISSISSIPPI DEPARTMENT OF NATURAL RESOURCES

Bureau of Land and Water Resources

Southport Mall

P.O. Box 10631

Jackson, Mississippi 39209

WATER WELL DRILLERS LOG

Permit Applied For Sunflower 4-7-88

Coded 8579

date well completed

firm name

county well located

LANDOWNER

Limo Malabata

description of formations encountered

from

to

Box 496

Clay
Fine Sand
SAND
M Sand + Gravel

0	30
30	88
88	90
90	131

Shaw Ms 38773 (mailing address)

WELL LOCATION:

126D sec. 7 T20N R5S 3 miles SE of Shaw (distance) (direction) (nearest town)

WELL PURPOSE: Irrigation (home, irrigation, municipal, industrial)

WELL COMPLETION DATA:

- (1) diameter (inches) 12"
- (2) total depth (feet) 131'
- (3) static water level (feet) _____ below above top of ground.
- (4) casing steel (material), (depth) 12" (size) if telescope see back.
- (5) screen 40' (length), (depth to top) 12" (size) (material)
- (6) pump 30 (HP) 1500 (yield gpm) Gear (type power)
- (7) electric log No (yes or no) None (organization running log)
- (8) how well bottom plugged Plate

RECEIVED


MAY 02 1988

Department of Natural Resources
Bureau of Land & Water Resources

DRILLERS REMARKS:

If well telescopes please sketch and show depths.

GROUND LEVEL

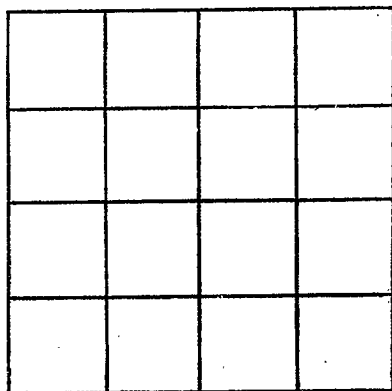

SECTION _____

Please indicate well location X.

ADDITIONAL INFORMATION

If more than one screen,
show locations of each on sketch.