

MISSISSIPPI DEPARTMENT OF NATURAL RESOURCES

Bureau of Land and Water Resources

Southport Mall

P.O. Box 10631

Jackson, Mississippi 39209

WATER WELL DRILLERS LOG

Permit Applied For SUNFLOWER

69 Sept 77

4-8 1988 Days Well Sunflower  
 date well completed firm name county well located


LANDOWNER: Jimmy Sellers  
Rt P Box 6  
Shaw Ms. 38773  
 (mailing address)

description of formations encountered	from	to
<u>Clay</u>	<u>0</u>	<u>70</u>
<u>Sand &amp; gravel</u>	<u>70</u>	<u>115</u>

WELL LOCATION:  
 127C sec 29 T 20 N R 5  
4 miles SE of Shaw  
 (distance) (direction) (nearest town)

WELL PURPOSE: Irrigation  
 (home, irrigation, municipal, industrial)

- WELL COMPLETION DATA:
- (1) diameter (inches) 10"
  - (2) total depth (feet) 115'
  - (3) static water level (feet) \_\_\_\_\_ below  
 top of ground above
  - (4) casing steel \_\_\_\_\_  
 (material) (depth)
  - 10" if telescope see back.  
 (size)
  - (5) screen 40 \_\_\_\_\_  
 (length) (depth to top)
  - 10" \_\_\_\_\_  
 (size) (material)
  - (6) pump 30 1300  
 (HP) (yield gpm)
  - Flu  
 (type power)
  - (7) electric log No  
 (yes or no)
  - No one  
 (organization running log)
  - (8) how well bottom plugged Plate

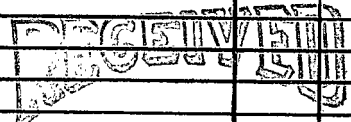


JULY 09 1988

Department of Natural Resources  
 Bureau of Land & Water Resources

DRILLERS REMARKS:

If well telescopes please  
sketch and show depths.

GROUND LEVEL

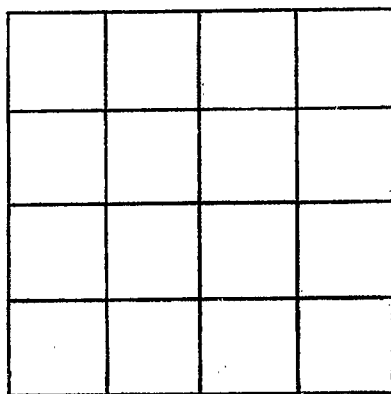

SECTION \_\_\_\_\_

Please indicate well location X.

ADDITIONAL INFORMATION

If more than one screen,  
show locations of each on sketch.