

MISSISSIPPI DEPARTMENT OF NATURAL RESOURCES

Bureau of Land and Water Resources

Southport Mall

P.O. Box 10631

Jackson, Mississippi 39209

WATER WELL DRILLERS LOG

Permit Applied For 572

4-30 1988 date well completed

Dyer Well firm name

Sunflower county well located

LANDOWNER: Jimmy Shelton
 Rt 1 Box 6
 Shaw, Ms. 38773
 (mailing address)

description of formations encountered	from	to
CLAY	0	45
Fine SAND	45	75
M Sand + Gravel	75	80
Sand + Gravel	80	117

WELL LOCATION:
 sec. 5 T 20 N R 5 E
 3 miles E of SHAW
 (distance) (direction) (nearest town)

WELL PURPOSE: Irrigation
 (home, irrigation, municipal, industrial)

- WELL COMPLETION DATA:
- (1) diameter (inches) 12"
 - (2) total depth (feet) 117'
 - (3) static water level (feet) _____ below above top of ground.
 - (4) casing steel (material), _____ (depth), 12" (size) if telescope see back.
 - (5) screen 40' (length), _____ (depth to top), 12" (size), _____ (material)
 - (6) pump 40 (HP), 2000 (yield gpm), Elec (type power)
 - (7) electric log No (yes or no), None (organization running log)
 - (8) how well bottom plugged Plate


RECEIVED
 JUN 06 1988

Department of Natural Resources
 Bureau of Land & Water Resources

DRILLERS REMARKS:

If well telescopes please sketch and show depths.

GROUND LEVEL

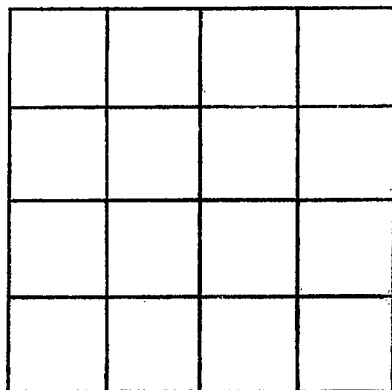

SECTION _____

Please indicate well location X.

ADDITIONAL INFORMATION

If more than one screen,
show locations of each on sketch.