

MISSISSIPPI DEPARTMENT OF NATURAL RESOURCES

Bureau of Land and Water Resources

Southport Mall

P.O. Box 10631

Jackson, Mississippi 39209

WATER WELL DRILLERS LOG

Permit Applied For F 73
CODED

date well completed 6-7-88 Dyer Well firm name Sunflower county well located

LANDOWNER: John Farms

description of formations encountered

from to

Box 468
Shaw Ms. 38773
 (mailing address)

<u>Clay</u>	<u>0</u>	<u>28</u>
<u>F Sand + Gravel</u>	<u>28</u>	<u>60</u>
<u>M Sand</u>	<u>60</u>	<u>80</u>
<u>Sand + Gravel</u>	<u>80</u>	<u>98</u>
<u>Fine Sand + Gravel</u>	<u>98</u>	<u>105</u>
<u>Sand + Gravel</u>	<u>105</u>	<u>110</u>
<u>M Sand + Gravel</u>	<u>110</u>	<u>120</u>

WELL LOCATION:

sec. 29 T. 20 N. R. 5 E. 5 miles SE of Shaw
 (distance) (direction) (nearest town)

WELL PURPOSE: Irrigation
 (home, irrigation, municipal, industrial)

WELL COMPLETION DATA:

- (1) diameter (inches) 16"
- (2) total depth (feet) 120'
- (3) static water level (feet) _____ below
 top of ground. above
- (4) casing steel (material) _____ (depth)
16" If telescope see back.
 (size)
- (5) screen 40' (length) _____ (depth to top)
16" (size) _____ (material)
- (6) pump 60 (HP) _____ (yield gpm)
Gear (type power)
- (7) electric log No (yes or no)
None (organization running log)
- (8) how well bottom plugged Plate

RECEIVED


JUL 11 1988

Department of Natural Resources
 Bureau of Land & Water Resources

DRILLERS REMARKS:

If well telescopes please sketch and show depths.

GROUND LEVEL

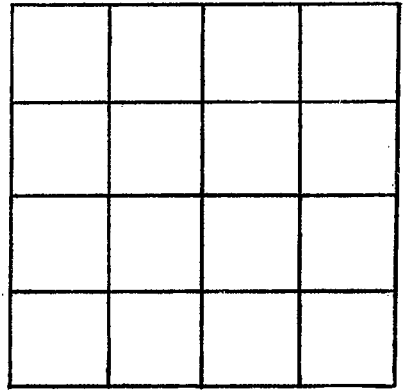

SECTION _____

Please indicate well location X.

ADDITIONAL INFORMATION

If more than one screen,
show locations of each on sketch.