

MISSISSIPPI DEPARTMENT OF NATURAL RESOURCES

Bureau of Land and Water Resources

Southport Mall

P.O. Box 10631

Jackson, Mississippi 39209

WATER WELL DRILLERS LOG

CODED

Sunflower
T 76
5/19/85
GW 153

5-19
date well completed

1985 BUTANE GAS COMPANY
OF GREENWOOD

Sunflower
county well located

LANDOWNER:	description of formations encountered	from	to
John Britt Indianola, Miss. (mailing address)		CLAY FINE SAND sand gravel	0 15 60
WELL LOCATION:	CODED		
sec. <u>25</u> T <u>20</u> N R <u>5</u> E 7 miles <u>N</u> of <u>Indianola</u> (distance) (direction) (nearest town)			
WELL PURPOSE: <u>Fish pond</u> (home, irrigation, municipal, industrial)			
WELL COMPLETION DATA:			
(1) diameter (inches) <u>8"</u>			
(2) total depth (feet) <u>105'</u>			
(3) static water level (feet) <u>20'</u> <u>below</u> top of ground. <u>above</u>			
(4) casing <u>Steel</u> , <u>65'</u> (material) (depth)			
<u>8"</u> (size) if telescope see back.			
(5) screen <u>40'</u> , <u>65'</u> (length) (depth to top)			
<u>8"</u> , <u>Steel</u> (size) (material)			
(6) pump <u>15</u> <u>500</u> (HP) (yield gpm)			
<u>Elect</u> (type power)			
(7) electric log <u>NO</u> (yes or no)			
<u>NO</u> (organization running log)			
(8) how well bottom plugged <u>Steel plate</u>			
DRILLERS REMARKS: <u>Richard Vest</u>			


RECEIVED

JUN - 4 1985

Department of Natural Resources
Bureau of Land & Water Resources

If well telescopes please sketch and show depths.

GROUND LEVEL

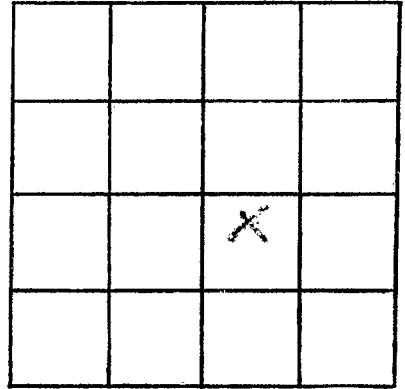

SECTION 25

Please indicate well location X.

ADDITIONAL INFORMATION

If more than one screen, show locations of each on sketch.