		ell Report	For Office Use Only:
County:Sunflower	Part 1		
Permit #: 60 41406	Mississippi Department of Environmental Quality		Aquifer:
Irrigation Equipment	Office of Land and Water Resources		Well #://
Driller:	P.O. Box 10631		
11-28-06	Jorither: $11 - 28 - 06$ Jackson, MS 39289-0631 Date drilling completed: $11 - 28 - 06$ (601)961-5210		L. S. Elevation:
Date drilling completed:	6 (601)961-5210 (601)354-6938 (fax)		E-log #:
] (001)554	-0750 (Iax)	
State Law requires that this rep 30 days of completion of drilling		lriller in detail and filed w	ith the Department within
Well Owner Informa	ation		Location
DwnerName		33 35 2,7.1 Latitude:	N Longitude: 41 37.
Mailing Address: 82 Hedgewoo	2?		Longitude: <u>90 °41 37</u> w): Conventional Survey,
Mailing Address:			
		NWUSGS quad, Hand-held	GPS, Survey-grade GPS
		SW1/SW 1/4 Sec 11	Twn_20NRng_5W
Shaw MS 3	8773		Manual Toma
	te Zip Code	Distance Direction 6 Miles East	Nearest Town of Shaw
662-754-63 Telephone No. ()	33		
	Well D	ata	
Purpose of Well (circle one) Home Ind	lustrial Public Supply	Irrigation Fish Culture	Other:
Date well drilling started: 11-28	•		
Date well drilling started:	Date w	ell drilling completed:	
If flowing, method of flow regulation: Va	lve Other (de	escribe)	
	_		
Static Water Level: <u>37'</u> feet al	pove or below (circle one) la	and surface Date measured:	11-29-00
Method of Measurement (circle one)	teel tape electric tape	air line other:	
Hole depth: 115 Well de		Well arouted to a depth of	10 feet
	\frown	Wen ground to a dopin or _	
	Bentonite Mix		
Casing length: 75 feet Casi	ng diameter: 16	inches Type of casing:	PVC Sch.40
Screen length: <u>40</u> feet Screen		inches Type of screen:	
Screen slot size: <u>.050</u> inches	Setting depth: From	<u>76</u> feet to <u>1</u>	<u>15</u> feet
	$\langle \rangle$		
Type of completion (circle all applicable):	Gravel packed Undern	reamed Telescoped Oper	hole Natural Development
Type of completion (circle all applicable):		reamed Telescoped Oper	
-	Other (describe):		
Type of completion (circle all applicable): Top of lap pipe or reduction in casing:	Other (describe):		
-	Other (describe):feet. If tel	escoped or more than one sci	een, describe on back of page
Top of lap pipe or reduction in casing: Logs run (circle all applicable): No log ru	Other (describe):feet. If tel	escoped or more than one sci	een, describe on back of page
Top of lap pipe or reduction in casing: Logs run (circle all applicable): No log ru Name of organization running log(s):	Other (describe): feet. If tel	escoped or more than one sci Density Sonic Neutron	een, describe on back of page Other:
Top of lap pipe or reduction in casing: Logs run (circle all applicable): No log ru Name of organization running log(s): I certify that the well was drilled, constr	Other (describe):feet. If teleum Electric Gamma Ray	escoped or more than one sci Density Sonic Neutron ccordance with all applicable	een, describe on back of page Other: e requirements of the Mississi
Top of lap pipe or reduction in casing: Logs run (circle all applicable): No log ru Name of organization running log(s): I certify that the well was drilled, constr Department of Environmental Quality :	Other (describe): feet. If tel In Electric Gamma Ray ructed, and completed in a and/or the Mississippi Dep	escoped or more than one sci Density Sonic Neutron ccordance with all applicable	een, describe on back of page Other: e requirements of the Mississi
Top of lap pipe or reduction in casing: Logs run (circle all applicable): No log ru Name of organization running log(s): I certify that the well was drilled, constr Department of Environmental Quality : Irrigation Equipm	Other (describe): feet. If tele m Electric Gamma Ray ructed, and completed in a and/or the Mississippi Dep nent Inc.	escoped or more than one sci Density Sonic Neutron ccordance with all applicable	een, describe on back of page Other: e requirements of the Mississi
Top of lap pipe or reduction in casing: Logs run (circle all applicable): No log ru Name of organization running log(s): I certify that the well was drilled, constr Department of Environmental Quality :	Other (describe): feet. If tel In Electric Gamma Ray ructed, and completed in a and/or the Mississippi Dep	escoped or more than one sci Density Sonic Neutron ccordance with all applicable	een, describe on back of page Other: e requirements of the Mississi

4

•

DEC 0 5 2006 BY: OLWR If well telescopes please sketch below and show depths.




Description of Formations Encountered	From To
Clay	0 28
Fine Sand	29 55
Fine Sand/gravel	56 65
Fine Sand/gravel Med. Sand/gravel	66 115
Meu. Sanu/graver	

د ع ۱۰۱۰

If more than one screen, show location of each on sketch

è

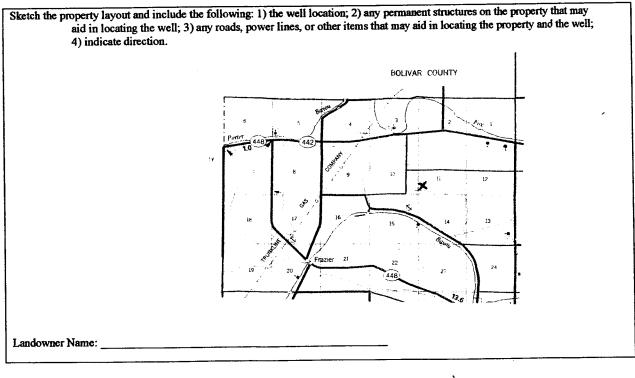

Signature of Water Well Contractor

 $\mathbf{x}_{\mathbf{v}}$

(STATE V	VELL REPORT		
County: Sunflower	•	Part 2 Pump Installer's Completion Report		For Office Use Only:	
Permit #: 6004140		Office of La	nent of Environmental Quality nd and Water Resources	Aquifer:	
Irrigation Equ	ipment	P.			
Date completed:11-2	<u>8–</u> 06	(6	Well #: Elevation:		
This was set should be as	non-ound by)354-6938 (fax)		
installation of pump.			ctail and filed with the Department		
	ner Inform:		Well	Location	
Owner Name: Walte	r Grif	fin	Latitude:Longitude:		
Mailing Address: 82 H	ledgewo	od Road	Method of Lat/Long (circle on	Method of Lat/Long (circle one): Conventional Survey,	
	·		USGS quad, Hand-	held GPS, Survey-grade G	
Sha	w MS	38773	SW 1/4 SW 1/4 Sec 11		
City	State	Zip Code	Distance Direction	Nearest Town	
Telephone Mar (
Telephone No. ()			Milesof	Shaw	
Pu	шр Туре			ver Type	
	Sircle one			rcle one	
Air Lift Jet		Submersible	Diesel Engine Gasoline	e Engine Natural (
Bucket Pist	on	Turbine	Electric Motor Hand	Tractor P	
Centrifugal Rot	ary	Flowing Well	Windmill Other (s	specify):	
Other (specify):			Horse Power Rating of Motor:	40	
Date Pump Installed:	11-	29-06	Setting Depth:	70 feet	
Rated Pump Capacity:1			Number of Stages:	2	
	p Test Data			suring Water Level rcle one	
Date Well Tested:					
Static Water Level (A):Feet Below Land Surface			uring Line Steel Tap		
Pumping Water Level (B):	Feet	Below Land Surface	Other (specify):		
Drawdown [(B) - (A)]:	Feet	Below Land Surface	For flowing well, measured shu	tt in head: f	
Test Pumping Rate: Gallons Per Minute		Well yielded			
Duration of Pump Test (minim		-		_	
		nours		hours of pump	
				RECEIV	