

RECEIVED

NOV 21 2007

BY: OLWR

State Well Report

Part I

Mississippi Department of Environmental Quality
Office of Land and Water Resources
P.O. Box 10631
Jackson, MS 39289-0631
(601)961-5210
(601)354-6938 (fax)

For Office Use Only:

Aquifer:
Well #: J-118
L.S. Elevation:
E-log #:

County: Sunflower
Exam #: 6W42253
Irrigation Equipment
Driller:
Date drilling completed: 11-12-07

State Law requires that this report be prepared by the driller in detail and filed with the Department within 30 days of completion of drilling of the well.

Well Owner Information: Owner Name Outback Land Co., Mailing Address 25 Charles Ellis Road, Indianola Ms. 38751, Telephone No. (662) 887-1596. Well Location: Latitude 33.32.19.2, Longitude 90.40.11.2, Method of Lat/Long Conventional Survey, SE 1/4 NW 1/4 Sec 36, Twn 20N, Rng 5W, Distance 5 Miles, Direction SW, Nearest Town Steiner.

Well Data: Purpose of Well Irrigation, Date well drilling started 11-12-07, Date well drilling completed 11-12-07, Static Water Level 34 feet above below land surface, Date measured 11-13-07, Method of Measurement steel tape, Hole depth 127, Well depth 127, Well grouted to a depth of 10 feet, Type of grout Bentonite, Casing length 87 feet, Casing diameter 10 inches, Type of casing PVC, Screen length 40 feet, Screen diameter 10 inches, Type of screen PVC, Screen slot size .050 inches, Setting depth From 88 feet to 127 feet, Type of completion Gravel packed, Top of lap pipe or reduction in casing, Logs run No log run.

Name of organization running log(s): Irrigation Equipment Inc. Patrick M. Chism 0695. I certify that the well was drilled, constructed, and completed in accordance with all applicable requirements of the Mississippi Department of Environmental Quality and/or the Mississippi Department of Health regulations and state laws.

Print Name of Water Well Contractor and License No. Signature of Water Well Contractor

RECEIVED

NOV 21 2007

BY: OLWR

STATE WELL REPORT

Part 2

Pump Installer's Completion Report
Mississippi Department of Environmental Quality
Office of Land and Water Resources
P.O. Box 10631
Jackson, MS 39289-0631
(601)961-5210
(601)354-6938 (fax)

For Office Use Only:

Applicator:

Well #: J-118

Elevation:

County: Sunflower
Report #: GW42253
Irrigation Equipment
Driller:
Date completed: 11-12-07

This report should be prepared by the pump installer in detail and filed with the Department within 30 days of the installation of pump.

Well Owner Information

Owner Name: Outback Land Co.
Mailing Address: 25 Charles Ellis Road
Indianola Ms. 38751
City State Zip Code
Telephone No. ()

Well Location

Latitude: Longitude:
Method of Lat/Long (circle one): Conventional Survey,
USGS quad, Hand-held GPS, Survey-grade GPS
SE 1/4 NW 1/4 Sec 36 Twn 20N Rng 5W
Distance Direction Nearest Town
5 Miles SW of Steiner

Pump Type
Circle one

Air Lift Jet Submersible
Bucket Piston Turbine
Centrifugal Rotary Flowing Well

Power Type
Circle one

Diesel Engine Gasoline Engine Natural Gas
Electric Motor Hand Tractor PTO
Windmill Other (specify):

Other (specify):
Date Pump Installed: 11-13-07
Rated Pump Capacity: 750 +/- Gallons Per Minute

Horse Power Rating of Motor: 15
Setting Depth: 70 feet
Number of Stages: 1

Pump Test Data

Date Well Tested:
Static Water Level (A): Feet Below Land Surface
Pumping Water Level (B): Feet Below Land Surface
Drawdown [(B)-(A)]: Feet Below Land Surface
Test Pumping Rate: Gallons Per Minute
Duration of Pump Test (minimum 4 hours): hours

Method of Measuring Water Level
Circle one


Air Line Electric Measuring Line Steel Tape
Other (specify):
For flowing well, measured shut in head: feet
Well yielded GPM with a drawdown of
feet after hours of pumping

I HEREBY CERTIFY that the above statements are true to the best of my knowledge.


Patrick M. Chism 0695

Print Name of Pump Installer and License No. (if applicable)

Signature of Pump Installer

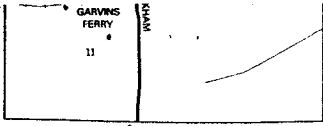

Inset B
T 18 N R 4 W

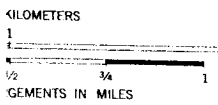

6W42253

Outback Land Co.
Map

