

# State Well Report

## Part 1

Mississippi Department of Environmental Quality  
Office of Land and Water Resources  
P.O. Box 10631  
Jackson, MS 39289-0631  
(601)961-5210  
(601)354-6938 (fax)

County: Sunflower  
Permit #: 0W42365  
Driller: Irrigation Equipment  
Date drilling completed: 3-5-08

For Office Use Only:  
Aquifer: \_\_\_\_\_  
Well #: J-119  
L. S. Elevation: \_\_\_\_\_  
E-log #: \_\_\_\_\_

State Law requires that this report be prepared by the driller in detail and filed with the Department within 30 days of completion of drilling of the well.

Well Owner Information	Well Location
Owner Name: <u>Pitts Farms</u>	Latitude: <u>33° 32' 36.9"</u> Longitude: <u>90° 40' 46.3"</u>
Mailing Address: <u>P.O. Box 925</u>	Method of Lat/Long (circle one): <u>Conventional Survey</u>
<u>Indianola</u> Ms. <u>38751</u>	USGS quad, Hand-held GPS, Survey-grade GPS
City State Zip Code	<u>SW</u> 1/4 <u>SE</u> 1/4 Sec <u>26</u> Twn <u>20N</u> Rng <u>5W</u>
Telephone No. <u>662 887-4551</u>	Distance <u>5</u> Miles Direction <u>NW</u> of Nearest Town <u>Indianola</u>

Well Data

Purpose of Well (circle one) Home Industrial Public Supply Irrigation Fish Culture Other: \_\_\_\_\_

Date well drilling started: 3-5-08 Date well drilling completed: 3-5-08

If flowing, method of flow regulation: Valve \_\_\_\_\_ Other (describe) \_\_\_\_\_

Static Water Level: 25 feet above or below (circle one) land surface Date measured: 3-5-08

Method of Measurement (circle one) steel tape electric tape air line other: \_\_\_\_\_

Hole depth: 138 Well depth: 138 Well grouted to a depth of 10 feet

Type of grout (circle one): Cement Bentonite Mix

Casing length: 100 feet Casing diameter: 16 inches Type of casing: PVC

Screen length: 38 feet Screen diameter: 16 inches Type of screen: PVC

Screen slot size: see back inches Setting depth: From see back feet to \_\_\_\_\_ feet

Type of completion (circle all applicable): Gravel packed Underreamed Telescoped Open hole Natural Development

Other (describe): \_\_\_\_\_


Top of lap pipe or reduction in casing: \_\_\_\_\_ feet. If telescoped or more than one screen, describe on back of page

Logs run (circle all applicable): No log run Electric Gamma Ray Density Sonic Neutron Other: \_\_\_\_\_

Name of organization running log(s): \_\_\_\_\_

I certify that the well was drilled, constructed, and completed in accordance with all applicable requirements of the Mississippi Department of Environmental Quality and/or the Mississippi Department of Health regulations and state laws.

Irrigation Equipment Inc.  
Patrick M. Chism 0695

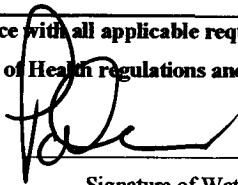

Print Name of Water Well Contractor and License No.

Signature of Water Well Contractor

RECEIVED  
MAR 11 2008  
BY: OLWR



# STATE WELL REPORT

## Part 2

**Pump Installer's Completion Report**  
 Mississippi Department of Environmental Quality  
 Office of Land and Water Resources  
 P.O. Box 10631  
 Jackson, MS 39289-0631  
 (601)961-5210  
 (601)354-6938 (fax)

County: Sunflower  
 Permit #: GW42365  
 Drilling: Irrigation Equipment  
 Date completed: 3-5-08

For Office Use Only:

Aquifer: \_\_\_\_\_  
 Well #: J-119  
 Elevation: \_\_\_\_\_

This report should be prepared by the pump installer in detail and filed with the Department within 30 days of the installation of pump.

Well Owner Information	Well Location
Owner Name: <u>Pitts Farms</u>	Latitude: _____ Longitude: _____
Mailing Address: <u>P.O. Box 925</u>	Method of Lat/Long (circle one): Conventional Survey, USGS quad, Hand-held GPS, Survey-grade GPS
<u>Indianola Ms. 38751</u> City State Zip Code	<u>SW 1/4 SE 1/4 Sec 26 Twn 20N Rng 5W</u>
Telephone No. <u>662 887-4551</u>	Distance Direction Nearest Town <u>5 Miles NW of Indianola</u>

Pump Type Circle one	Power Type Circle one
Air Lift Jet Submersible	Diesel Engine Gasoline Engine Natural Gas
Bucket Piston <u>Turbine</u>	<u>Electric Motor</u> Hand Tractor PTO
Centrifugal Rotary Flowing Well	Windmill Other (specify): _____
Other (specify): _____	Horse Power Rating of Motor: <u>60</u>
Date Pump Installed: <u>3-5-08</u>	Setting Depth: <u>70</u> feet
Rated Pump Capacity: <u>2800±</u> Gallons Per Minute	Number of Stages: <u>1</u>

Pump Test Data	Method of Measuring Water Level Circle one
Date Well Tested: _____	Air Line Electric Measuring Line Steel Tape
Static Water Level (A): _____ Feet Below Land Surface	Other (specify): _____
Pumping Water Level (B): _____ Feet Below Land Surface	For flowing well, measured shut in head: _____ feet
Drawdown [(B) - (A)]: _____ Feet Below Land Surface	Well yielded _____ GPM with a drawdown of _____ feet after _____ hours of pumping
Test Pumping Rate: _____ Gallons Per Minute	
Duration of Pump Test (minimum 4 hours): _____ hours	


I HEREBY CERTIFY that the above statements are true to the best of my knowledge.

Patrick M. Chism 0695 [Signature]  
 Print Name of Pump Installer and License No. (if applicable) Signature of Pump Installer


RECEIVED

MAR 11 2008

BY: OLWR

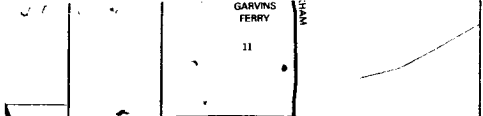


Inset B  
T 18 N R 4 W

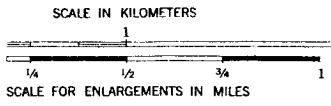

6047365

# Pitts Farms Map

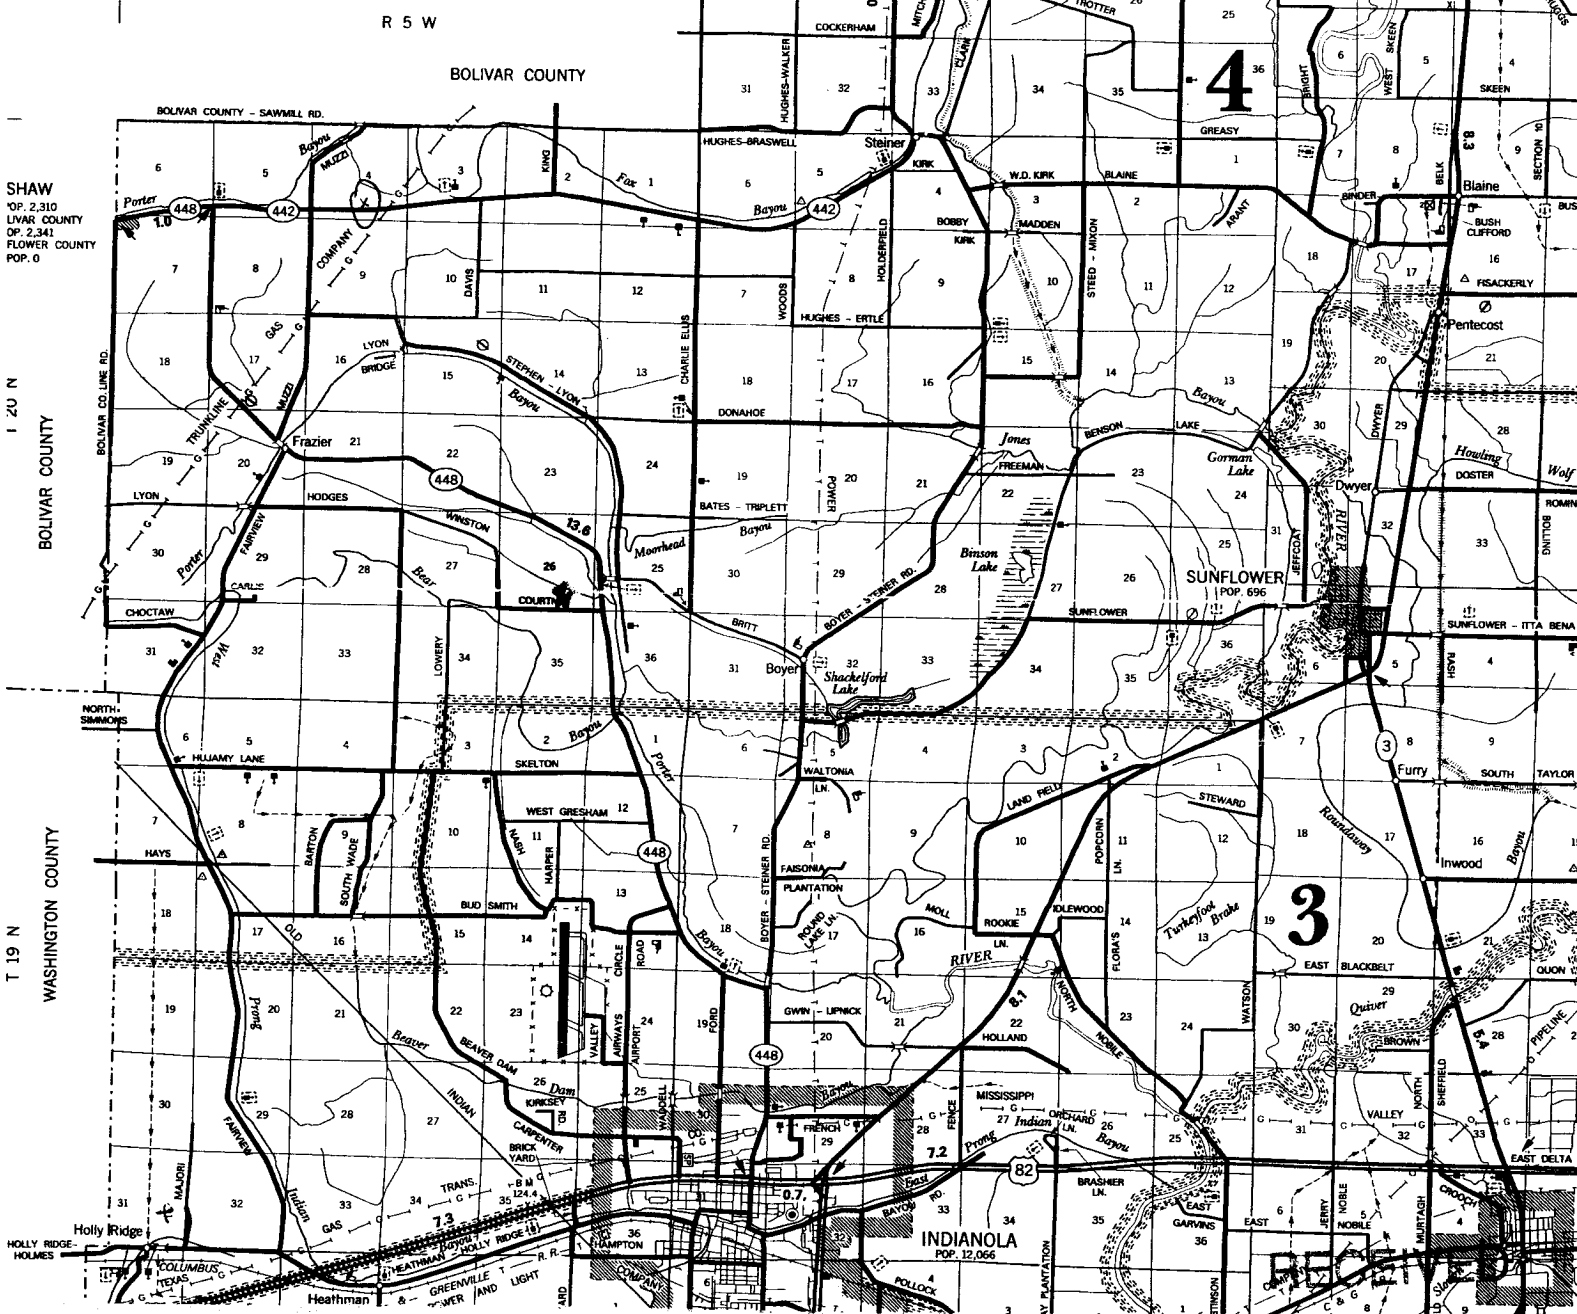

J-189

4

3

RECEIVED

MAR 11 2008

BY OLWR