

**MISSISSIPPI DEPARTMENT OF NATURAL RESOURCES**  
Bureau of Land and Water Resources

P.O. Box 10631  
Jackson, Mississippi 39209  
**WATER WELL DRILLERS LOG**

COUNTY WELL LOCATED  
Sunflower

WELL NUMBER 2004 CODED

DATE WELL COMPLETED  
3-23-90

PERMIT NUMBER

NAME OF DRILLING FIRM  
Dym Well

NAME & MAILING ADDRESS OF LANDOWNER  
Jimmy B. Muzzi  
Rt 1 Box 48A  
Shaw Ms. 38773

WELL LOCATION: SEC 21 TOWNSHIP 20 RANGE 5  
N S E W

DISTANCE \_\_\_\_\_ MILES \_\_\_\_\_ OF \_\_\_\_\_ NEAREST TOWN

OTHER LANDMARK

WELL PURPOSE: Home Irrigation Municipal, Industrial, Fish Pond, etc.

**PUMP DATA**

PUMP TYPE (Circle One):  
Submersible Turbine, Jet, Flowing Well,  
Other (Describe) \_\_\_\_\_

POWER TYPE (Circle One):  
Electric Tractor, Diesel, Gasoline, Butane,  
Other (Describe) \_\_\_\_\_ H/P \_\_\_\_\_

Pump Capacity (GPM) 830 No. of Stages 1 Setting Depth 50 FT.

PUMP TEST  
Well yielded \_\_\_\_\_ GPM with  
a drawdown of \_\_\_\_\_ ft.  
after \_\_\_\_\_ hours of pumping

**WELL DATA**

Well Depth <u>115'</u>	Casing Diameter (In.) <u>10"</u>	Casing Length (Ft.) <u>75'</u>
Type of Casing <u>steel</u>	Hole Depth	Depth to Static Water Level

TYPE OF COMPLETION: (Circle One or More):  
Gravel Packed Underreamed, Telescoped,  
Natural Development, Open Hole, Other

Top of Lap Pipe or Reduction in Casing  
FEET IF TELESCOPED OR MORE THAN ONE SCREEN: USE BACK PAGE

**LOG DATA**

TYPE OF LOG RUN (Circle One):  
No Log Run  
Electric, Gamma Ray, Density, Sonic, Neutron,  
Other (Describe) \_\_\_\_\_

Name of Organization Running Log  
None

**SCREEN DATA**

Diameter - Inches <u>10"</u>	Length - Feet <u>40'</u>	Slot Size - Inches <u>.030</u>
Screen Type <u>Wire Wrap</u>	Depth to Bottom - Feet	

**GEOLOGIC DATA (Office Use Only)**

Surface Elev.	Geologic Unit	Unit Thickness	Depth to Top
Subs. SWL	Date	Analysis	Aquifer Test

Driller's Remarks

**RECEIVED**


**OCT 26 1990**

DESCRIPTION OF FORMATIONS ENCOUNTERED	FROM	TO	FORMATIONS (Continued)	FROM	TO
<u>Clay</u>	<u>0</u>	<u>28</u>	<b>Bureau of Land &amp; Water Resources</b>		
<u>Fine Sand</u>	<u>28</u>	<u>40</u>			
<u>M Sand + Gravel</u>	<u>40</u>	<u>100</u>			
<u>Sand + Gravel</u>	<u>100</u>	<u>115</u>			

IF MORE SPACE IS NEEDED, USE BACK

If well telescopes please  
sketch and show depths.

GROUND LEVEL

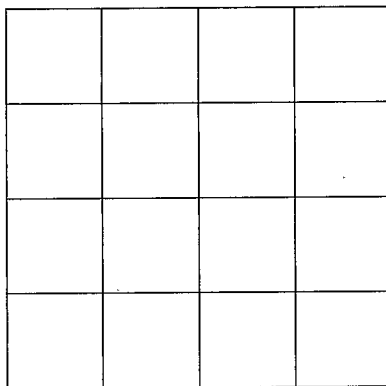

SECTION \_\_\_\_\_

Please indicate well location X.

ADDITIONAL INFORMATION

If more than one screen,  
show location of each on sketch.