

K 22  
9-13-65

WATER WELL DRILLERS LOG

**CODED**

SUNFLOWER  
Washington

Date: 9/13, 1965, Driller: Bailey Drly Co County Washington  
(Name)

(1) Owner of Land: Ratliff + Tribble  
(Name)  
Shaw, Miss.  
(Address) 4

(2) Location: 1/4, 1/4, Sec. 3 20 R 4  
10 miles E of Shaw  
(distance) (direction) (Nearest Town)

(3) Topography: Flat  
(Hilly) (Flat) (Level) ↑

(4) Purpose of Well: Domestic  
(Domestic Irrigation  
Municipal, Industrial, Other)

Description & Color of Materials Sand, Clay, Red Clay, Shell, etc.	Thick- ness Feet	Depth Feet
Clay		75
Sand		82
Gravel		136
Sand		315
Mud		335
Sand + mud		500
Mud		528
Sand		561
Mud		611
Sand		671
Mud + rocks		1240
Brown sand		1257
Mud + sand		1271
Mud		1340
Rock		1341
Mud		1415
Sand		1570

Information upon completion of well:

(1) Diameter 4 X 3 X 2 1/2 inches.

(2) Total Depth 1570 feet.

(3) Water Level 45 feet above below top of ground.

(4) Cased to all way, Size 4 X 3 X 2 1/2

(5) Screen: Size 30, Length 2 1/2  
2 1/2 30 ft


(6) Were any formations sealed against pollution?  
\_\_\_\_\_ yes, X no.

**CODED**

If YES depth of formation \_\_\_\_\_

Why \_\_\_\_\_

Drillers Remarks: \_\_\_\_\_

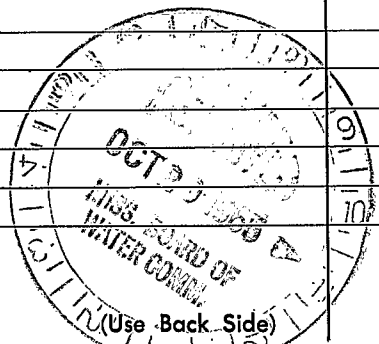

Well No.

