

SUNFLOWER  
K 23  
4-29-71

MISSISSIPPI  
BOARD OF WATER COMMISSIONERS  
416 North State Street  
Jackson, Mississippi 39201

**CODED**

WATER WELL DRILLERS LOG

April 29 1971 Cleveland Drilling Co Sunflower  
date well completed firm name county well located

LANDOWNER:	description of formations encountered	from	to
Wayne Mc Graw	Clay		
Irishland, Miss	Clay	Top	38'
Doddsville (mailing address)	Sand	38'	84'
	Sand & Pea gravel	84'	164'
	Sand	164'	196'
	Clay	196'	220'
	Sand & Shell	220'	590'
	Clay	590'	687'
	Sand	687'	760'
<b>WELL LOCATION:</b>			
sec. 15 T. 20 N. R. 4 W.			
8 miles north of Indianola (distance) (direction) (nearest town)			
<b>WELL PURPOSE:</b> Home (home, irrigation, municipal, industrial)			
<b>WELL COMPLETION DATA:</b>			
(1) diameter (inches)	14" x 2"		
(2) total depth (feet)	756'		
(3) static water level (feet)	31'	below	above
		top of	ground.
(4) casing (material)	galv.	736'	(depth)
(size)	If telescope see back.		
(5) screen (length)	20'	736'	(depth to top)
(size)	2"	3.5'	(material)
(6) pump (HP)	1	30	(yield gpm)
(type power)	Elec.		
(7) electric log (yes or no)	no		
(organization running log)			
(8) how well bottom plugged	wash & blue		
<b>DRILLERS REMARKS:</b>			


**CODED**

MAY 18 1971

MISS. Bd. of  
WATER COMMISSIONERS

If well telescopes please sketch and show depths.

GROUND LEVEL

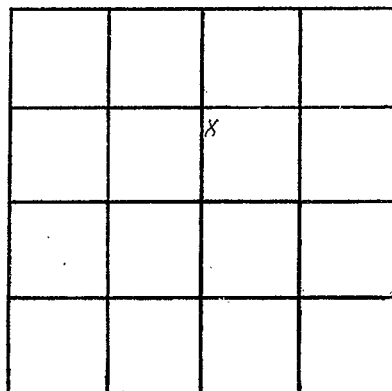

SECTION 15

Please indicate well location X.

ADDITIONAL INFORMATION

If more than one screen,  
show locations of each on sketch.