

Sunflower

K 26

2/68

MISSISSIPPI BOARD OF WATER COMMISSIONERS  
416 North State Street  
Jackson, Mississippi 39201

WATER WELL DRILLERS LOG

FIVE COUNTY FARMERS ASSN

2-12-68

SUNFLOWER

date well completed

firm name

county well located

LANDOWNER: J P FISHER JR

description of formations encountered

from

to

SUNFLOWER MISS

FINE SAND

0

59 1/2

MED SAND

59 1/2

79

Coarse Sand + gravel

79

121

clay

121

131

(mailing address)

WELL LOCATION:

sec. 25 T 29 N R. 4 W

2 miles West of Sunflower

(distance) (direction) (nearest town)

WELL PURPOSE: IRRIGATION

(home, irrigation, municipal, industrial)

WELL COMPLETION DATA:

(1) diameter (inches) 6"

(2) total depth (feet) 127

(3) static water level (feet) 23 below top of ground.

(4) casing 6" Pipe, 79'

(material) (depth)

6" if telescope see back.

(size)

(5) screen 48', 79'

(length) (depth to top)

6" Screen 101'

(size) (material)

(6) pump 14HP 1000

(HP) (yield gpm)

(type power)


(7) electric log NO

(yes or no)

(organization running log)


(8) how well bottom plugged

DRILLERS REMARKS:

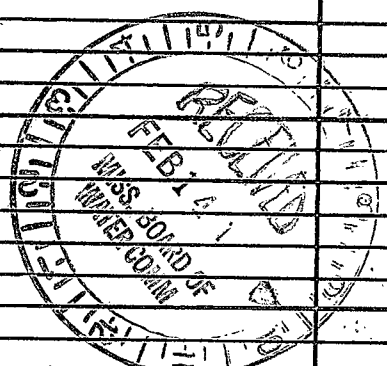

If well telescopes please sketch and show depths.

GROUND LEVEL

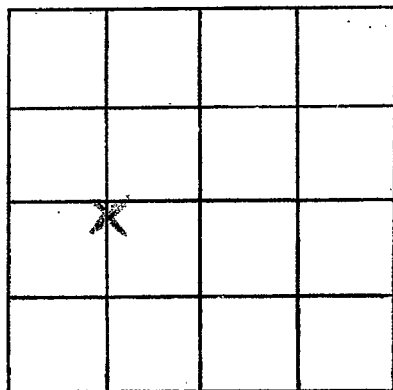

SECTION 25

Please indicate well location X.

ADDITIONAL INFORMATION

If more than one screen,  
show locations of each on sketch.