

Sunflower
K 27
11-67

MISSISSIPPI
 BOARD OF WATER COMMISSIONERS
 416 North State Street
 Jackson, Mississippi 39201

WATER WELL DRILLERS LOG

Nov 3 67 19 Betane Gas of Greenwood Sunflower
 date well completed firm name county well located

LANDOWNER:
Billy Floyd
RT 1 - Doddsville Miss
 (mailing address)


description of formations encountered		from	to

WELL LOCATION:
 sec. 9 T. 20 N R. 4 E
1 1/2 miles S of Stattler
 (distance) (direction) (nearest town)

<u>Sand</u>	<u>690</u>	<u>760</u>
<u>SHAPE</u>	<u>760</u>	
<u>963 T.D. Test Hole</u>		

WELL PURPOSE: Home
 (home, irrigation, municipal, industrial)

- WELL COMPLETION DATA:
- diameter (inches) 4" x 2"
 - total depth (feet) 755'
 - static water level (feet) 22 below top of ground, 4" - .105 Gals.
 - casing 2" - 630 Gals. (material) (depth)
 _____ if telescope see back. (size)
 - screen 20 , 735' (length) (depth to top)
2" , STAINLESS (size) (material)
 - pump 1 , 15 (HP) (yield gpm)
Electric (type power)
 - electric log No (yes or no)
 _____ (organization running log)
 - how well bottom plugged _____
Back Press. Valve

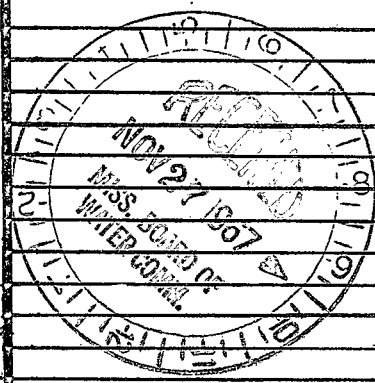

DRILLERS REMARKS:

If well telescopes please sketch and show depths.

GROUND LEVEL

Casing Galv

4"

105'

Casing Galv

2"

630'

735

20' of Screen

T.D. 755'

			X

SECTION 9

Please indicate well location X.

ADDITIONAL INFORMATION

If more than one screen, show locations of each on sketch.