

MISSISSIPPI
BOARD OF WATER COMMISSIONERS
416 North State Street
Jackson, Mississippi 39201

WATER WELL DRILLERS LOG

Sunflower
K 28
9-67

date well completed 9/27 1967 firm name Bailey Drilling Co county well located Sunflower

LANDOWNER: William Pitts
Indianola
Miss.
(mailing address)

description of formations encountered	from	to
Clay	0	30
Sand	30	70
Gravel	70	135
Mud + Sand	135	1018
Rock + Mud	1018	1327
Sand	1327	1370


WELL LOCATION:
sec 24 T 20 N R 4 E
S W
8 miles W of Indianola
(distance) (direction) (nearest town)

WELL PURPOSE: Farm
(home, irrigation, municipal, industrial)

WELL COMPLETION DATA:

- (1) diameter (inches) 4 X 3 X 2 1/2
- (2) total depth (feet) 1370
- (3) static water level (feet) 20 ^{below} _{above} top of ground.
- (4) casing Steel
(material) (depth)
4 X 3 X 2 1/2 if telescope see back.
(size)
- (5) screen 30' 1340
(length) (depth to top)
2 1/2" Stainless Steel
(size) (material)
- (6) pump 3 40
(HP) (yield gpm)
Elec
(type power)
- (7) electric log No
(yes or no)
(organization running log)
- (8) how well bottom plugged
Back pressure valve

DRILLERS REMARKS:

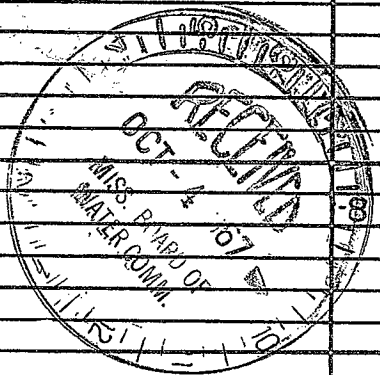

If well telescopes please sketch and show depths.


GROUND LEVEL

127' 4"

873' 3"

600' 2 1/2"

20 ft 2 1/2" screen

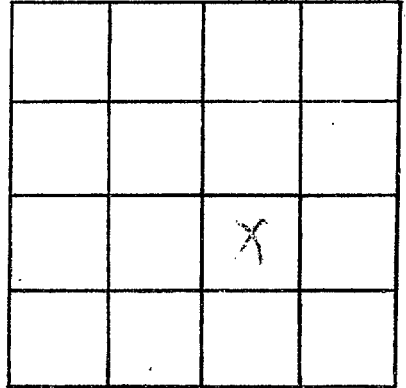

SECTION _____

Please indicate well location X.

ADDITIONAL INFORMATION

If more than one screen,
show locations of each on sketch.