

SUNFLOWER
K 29
5-67
Elec Log

MISSISSIPPI
BOARD OF WATER COMMISSIONERS
416 North State Street
Jackson, Mississippi 39201

WATER WELL DRILLERS LOG

MAY 1 1967 DELTA DRILLING Co. SUNFLOWER
date well completed firm name county well located

LANDOWNER: A.E. STEED

DODDSDVILLE, MISS.

(mailing address)


WELL LOCATION: SW 1/4 SW 1/4 NE 1/4
sec 14 T 20 N R 4 E
4 miles SOUTH of BLAINE
(distance) (direction) (nearest town)

WELL PURPOSE: DOMESTIC
(home, irrigation, municipal, industrial)

WELL COMPLETION DATA:

- (1) diameter (inches) 4
- (2) total depth (feet) 1240
- (3) static water level (feet) FLOWS Above top of ground.
- (4) casing STEEL (material), (depth),
2-3 1/4 (size) if telescope see back.
- (5) screen 20 (length), SEE REVERSE (depth to top)
2" STAINLESS STEEL (size) (material)
- (6) pump 3/4 (HP) 15 gpm FLOW (yield gpm)
ELEC (type power)
- (7) electric log YES (yes or no)
MISS. GEOLOGICAL SURVEY (organization running log)
- (8) how well bottom plugged BACK PRESSURE VALVE

description of formations encountered	from	to
gumbo	00	22
sand	22	91
gravel + HARD ROCK	91	146
sand	146	187
gumbo	187	209
sand	209	391
shale	391	476
gumbo	476	497
shale	497	538
gumbo	538	638
sand	638	668
shale	668	716
sand	716	774
shale	774	794
gumbo	794	898
green shale	898	1002
green sand	1002	1052
shale w/rocks	1052	1070
green sand	1070	1112
green shale	1112	1161
sand w/gumbo	1161	1172
green shale	1172	1213
sand w/shale	1213	1240

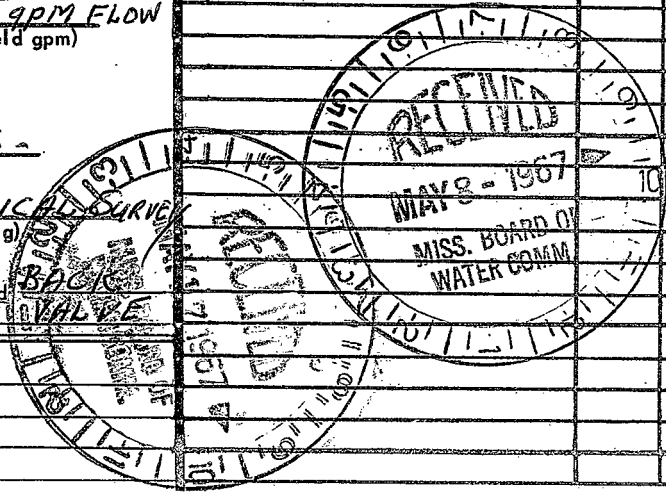

DRILLERS REMARKS:

