

Sun Flower

K 31 MISSISSIPPI BOARD OF WATER COMMISSIONERS

8-9-66

WATER WELL DRILLERS LOG

Sun Flower

Date: 8-9-, 1966, Driller: Fike County Furmen & Co. Coahoma
(Name)

(1) Owner of Land: P. F. Biskie &
(Name)
See-flower Miss
(Address)

(2) Location: NW 1/4, SE 1/4, Sec. 23 T. 4 N. R. 11 W.
2 miles NE of Smithland
(distance) (direction) (Nearest Town)

(3) Topography: Flat
(Hilly) (Flat) (Level)

(4) Purpose of Well: Irrigation
(Domestic Irrigation Municipal, Industrial, Other)

Description & Color of Materials Sand, Clay, Red Clay, Shell, etc.	Thick- ness Feet	Depth Feet
<u>Buckshot & Jaffred</u>		<u>27'</u>
<u>Sand + Gravel</u>	<u>13</u>	<u>40</u>
<u>Coarsesand</u>	<u>19 1/2</u>	<u>59 1/2</u>
<u>Fine Sand</u>	<u>26</u>	<u>85 1/2</u>
<u>Coarsesand + Gravel</u>		
<u>some larger rock</u>	<u>39</u>	<u>124 1/2</u>

Information upon completion of well:

(1) Diameter 6 inches.

(2) Total Depth 120 feet.

(3) Water Level 18 feet below top of ground.

(4) Cased to 72, Size 6"


(5) Screen: Size 6", Length 48'

(6) Were any formations sealed against pollution?
no.

If YES depth of formation _____

Why _____

Drillers Remarks: _____

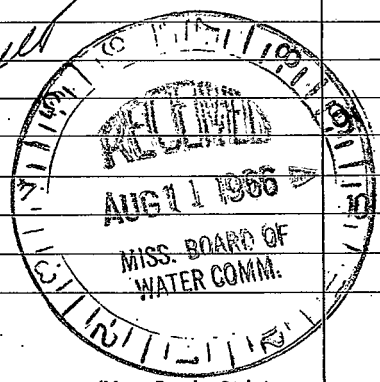

(Use Back Side)

Well No.

11
12
13

100