

MISSISSIPPI BOARD OF WATER COMMISSIONERS

SUNFLOWER
K 32
5-66

WATER WELL DRILLERS LOG

SUNFLOWER

Date: May 18, 1966, Driller: Butane Gas Co. County: Leflore
(Name)

- (1) Owner of Land: Primo Mutzi
(Name)
Shaw, Miss
(Address)
- (2) Location: NW 1/4, NE 1/4, Sec. 19 T19 R12W
6 miles East of Shaw
(distance) (direction) (Nearest Town)
- (3) Topography: Flat
(Hilly) (Flat) (Level)
- (4) Purpose of Well: Irrigation
(Domestic Irrigation
Municipal, Industrial, Other)

Description & Color of Materials Sand, Clay, Red Clay, Shell, etc.	Thick- ness Feet	Depth Feet
Clay	13	13
Fine Sand	10	23
Med. Sand	10	33
Med. Sand & Small Gravel	10	43
Fine Sand & gravel	10	53
" " "	10	63
" " "	10	73
Sand & gravel	10	83
" " "	10	93
" " "	10	103
" " "	10	113


Information upon completion of well:

- (1) Diameter 16 inches.
- (2) Total Depth 110 feet.
- (3) Water Level 15 feet below top of ground.
- (4) Cased to 70, Size 16.
- (5) Screen: Size 16, Length 40.
- (6) Were any formations sealed against pollution?
no.

If YES depth of formation _____

Why _____

Drillers Remarks: _____

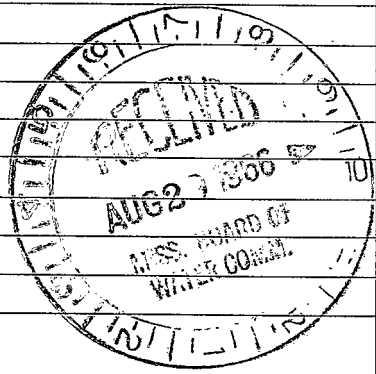

Retain this copy for your office files.

(Use Back Side)

Well No.

