

SUNFLOWER
K 33
G-1-17

MISSISSIPPI
BOARD OF WATER COMMISSIONERS
416 North State Street
Jackson, Mississippi 39201

CODED

WATER WELL DRILLERS LOG

6-1-1977
date well completed

Layne Central Co.
firm name

Sunflower
county well located

LANDOWNER: Ted Moll

Indianola, MS

(mailing address)

WELL LOCATION:

sec. 22 T 19 N R 4 W
8 miles N of Indianola
(distance) (direction) (nearest town)

WELL PURPOSE: Irrigation
(home, irrigation, municipal, industrial)

WELL COMPLETION DATA:

- (1) diameter (inches) 12"
- (2) total depth (feet) 99'
- (3) static water level (feet) 22' 1" below top of ground.
- (4) casing steel 59' (material) (depth)
12" (size) if telescope see back.
- (5) screen 40' 59' (length) (depth to top)
12" St. Steel (size) (material)
- (6) pump 25 1800 (HP) (yield gpm)
diesel (type power)
- (7) electric log NO (yes or no)

(organization running log)

St. Plate

(8) how well bottom plugged

DRILLERS REMARKS:


| description of formations encountered | from | to |
|---------------------------------------|------|-----|
| Clay | 0 | 12 |
| brown sand | 12 | 28 |
| coarse sand | 28 | 33 |
| coarse sand - pea gravel & blue clay | 33 | 48 |
| coarse sand & pea gravel | 48 | 67 |
| blue clay & sand | 67 | 74 |
| coarse sand & gravel | 74 | 84 |
| med. coarse sand | 84 | 89 |
| coarse sand & pea gravel | 89 | 92 |
| coarse sand & gravel | 92 | 99 |
| clay | 99 | 102 |

RECEIVED

AUG 8 1977

If well telescopes please sketch and show depths.

GROUND LEVEL

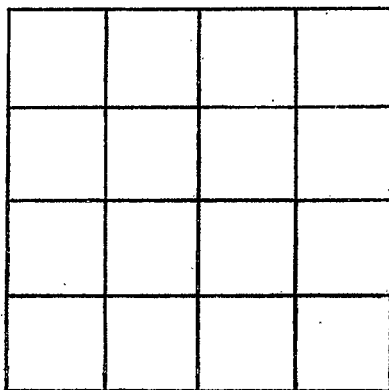

SECTION _____

Please indicate well location X.

ADDITIONAL INFORMATION

If more than one screen, show locations of each on sketch.