

SUNFLOWER
 CL-0736 **K34**
2-12-78

MISSISSIPPI
 BOARD OF WATER COMMISSIONERS
 416 North State Street
 Jackson, Mississippi 39201

CODED

WATER WELL DRILLERS LOG

2-12 1978 LAYNE CENTRAL CO. SUNFLOWER
 date well completed firm name county well located

LANDOWNER:
 Charlie Jacobs, Jr.
 514 Robinson Drive
 Cleveland, MS 38732
 (mailing address)

description of formations encountered	from	to
Clay	0	18
Fine Sand	18	50
Pea Gravel & Sand	50	65
Gravel & Sand	65	112

#1 WELL LOCATION:
 sec. 12 T. 20 N R. 4 W
 6 miles W of Sunflower
 (distance) (direction) (nearest town)

WELL PURPOSE: Irrigation
 (home, irrigation, municipal, industrial)

WELL COMPLETION DATA:
 (1) diameter (inches) 16"
 (2) total depth (feet) 112'
 (3) static water level (feet) 26 below top of ground.
 (4) casing Steel 72'
 (material) (depth)
 16" if telescope see back.
 (size)
 (5) screen 40' 72'
 (length) (depth to top)
 16" St. Steel
 (size) (material)
 (6) pump 30 1800
 (HP) (yield gpm)
 diesel
 (type power)
 (7) electric log no
 (yes or no)
 (organization running log)

(8) how well bottom plugged St. Plate


DRILLERS REMARKS:

CODED

RECEIVED
OCT. 5 1978

If well telescopes please sketch and show depths.

GROUND LEVEL

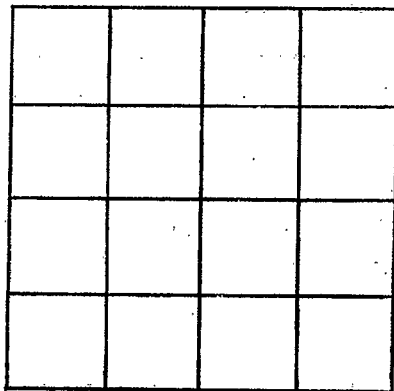

SECTION _____

Please indicate well location X.

ADDITIONAL INFORMATION

If more than one screen, show locations of each on sketch.