

SUNFLOWER
 CL-0736
 K 35
 4-1-78

MISSISSIPPI
 BOARD OF WATER COMMISSIONERS
 416 North State Street
 Jackson, Mississippi 39201

WATER WELL DRILLERS LOG

CODED

4-1 1978 LAYNE CENTRAL CO. SUNFLOWER
 date well completed firm name county well located

LANDOWNER: CHARLIE JACOBS
 Cleveland, MS
 (mailing address)

description of formations encountered	from	to
Clay	0	18
Sand	18	41
Coarse Sand	41	60
Coarse Sand & Gravel	60	108
Cemented Gravel	108	

#2 WELL LOCATION:
 sec. 12 T. 20 N R. 4 W
 5 miles SW of Doddsville
 (distance) (direction) (nearest town)

WELL PURPOSE: Irrigation
 (home, irrigation, municipal, industrial)

WELL COMPLETION DATA:
 (1) diameter (inches) 16"
 (2) total depth (feet) 108
 (3) static water level (feet) 24 below top of ground.
 (4) casing Steel 68'
 (material) (depth)
 16" if telescope see back.
 (size)
 (5) screen 40 68
 (length) (depth to top)
 16 St. Steel
 (size) (material)
 (6) pump 40 2000
 (HP) (yield gpm)
 electric
 (type power)
 (7) electric log no
 (yes or no)
 (organization running log)
 St. Plate
 (8) how well bottom plugged


CODED

RECEIVED
 OCT 5 1978

DRILLERS REMARKS:

If well telescopes please sketch and show depths.

GROUND LEVEL

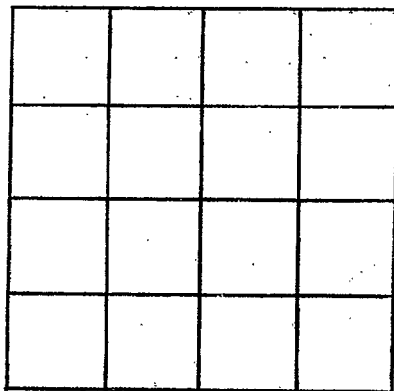

SECTION _____

Please indicate well location X.

ADDITIONAL INFORMATION

If more than one screen, show locations of each on sketch.