

SUNFLOWER  
K 36  
5-25-79

MISSISSIPPI  
BOARD OF WATER COMMISSIONERS  
416 North State Street  
Jackson, Mississippi 39201

CODED

WATER WELL DRILLERS LOG

5/25 1979 DYER WELL + IRR SUNFLOWER  
date well completed firm name county well located

LANDOWNER:  
HILL FARMS  
INDIANOLA  
(mailing address)

description of formations encountered	from	to
CLAY	0	20
FINE SAND	20	35
SAND	35	58
SAND + GRAVEL	58	110

WELL LOCATION:  
sec. 30 T 20 N R 4 E  
S (M)  
7 miles N of INDIANOLA  
(distance) (direction) (nearest town)

WELL PURPOSE:  
(home, irrigation, municipal, industrial)

WELL COMPLETION DATA:

(1) diameter (inches) 16

(2) total depth (feet) 110

(3) static water level (feet) 18 below top of ground.

(4) casing STEEL, 70 (material) (depth)  
16 if telescope see back. (size)

(5) screen 40, 70 (length) (depth to top)  
16, STEEL (size) (material)

(6) pump 60, 3000 (HP) (yield gpm)  
DIESEL (type power)

(7) electric log NO (yes or no)

(organization running log)

(8) how well bottom plugged PLATE

CODED

DEPT. OF NATURAL RESOURCES  
BUREAU OF LAND & WATER RESOURCES


OCT 29 1979

RECEIVED

DRILLERS REMARKS:

If well telescopes please sketch and show depths.

GROUND LEVEL

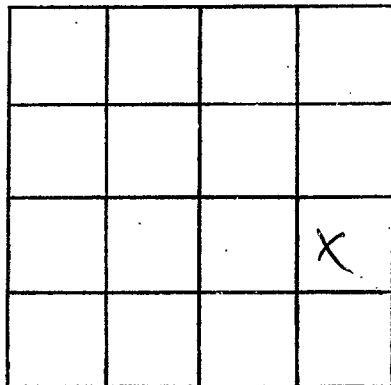

SECTION 30

Please indicate well location X.

ADDITIONAL INFORMATION

If more than one screen,  
show locations of each on sketch.