

MISSISSIPPI DEPARTMENT OF NATURAL RESOURCES

Bureau of Land and Water Resources

Southport Mall

P.O. Box 10631

Jackson, Mississippi 39209


WATER WELL DRILLERS LOG

CODED

SUNFLOWER
K37
8-14-80


08/14 1980 date well completed Larry's Well & Pump firm name Sunflower county well located

LANDOWNER: <u>Hiram Hill</u>	description of formations encountered	from	to
<u>Indianola MS</u> (mailing address)	<u>clay</u>	<u>0</u>	<u>25</u>
	<u>fine sand</u>	<u>25</u>	<u>42</u>
	<u>med sand</u>	<u>42</u>	<u>60</u>
	<u>course sand & gravel</u>	<u>60</u>	<u>104</u>
WELL LOCATION: sec. <u>18</u> T. <u>20</u> N. R. <u>4</u> E <u>10</u> miles <u>N</u> of <u>INDIANOLA</u> (distance) (direction) (nearest town)			
WELL PURPOSE: <u>Pick Pond</u> (home, irrigation, municipal, industrial)			
WELL COMPLETION DATA: (1) diameter (inches) <u>16"</u> (2) total depth (feet) <u>114'</u> (3) static water level (feet) <u>19'</u> below above top of ground. (4) casing <u>Steel</u> , <u>74'</u> (material) (depth) (size) if telescope see back. (5) screen <u>40'</u> , <u>74'</u> (length) (depth to top) <u>16"</u> , <u>Steel</u> (size) (material) (6) pump <u>60</u> , <u>3000</u> (HP) (yield gpm) (type power) (7) electric log <u>NO</u> (yes or no) (organization running log) (8) how well bottom plugged <u>Steel Plate</u>			
DRILLERS REMARKS:			

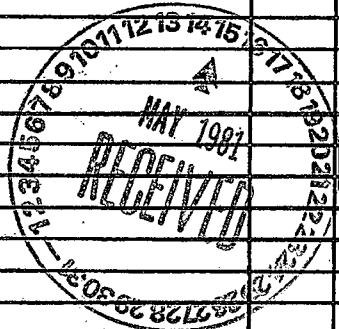

If well telescopes please sketch and show depths.

GROUND LEVEL

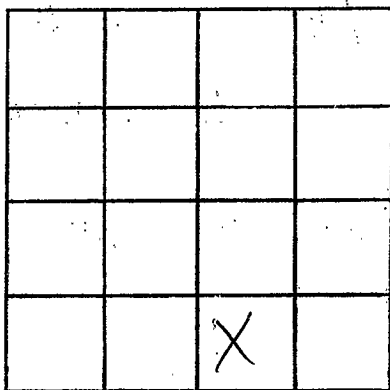

SECTION 18

Please indicate well location X.

ADDITIONAL INFORMATION

If more than one screen,
show locations of each on sketch.