

MISSISSIPPI DEPARTMENT OF NATURAL RESOURCES

Bureau of Land and Water Resources

Southport Mall

P.O. Box 10631

Jackson, Mississippi 39209

WATER WELL DRILLERS LOG

CODED

Sunflower
K 39
4-22-81

date well completed: 4-22-81 well name: Open Well # 2 Jug county well located: Sunflower

LANDOWNER: Bobby Kerk

description of formations encountered

Andalala MS
(mailing/address)

description of formations encountered	from	to
<u>Clay</u>	<u>0</u>	<u>28</u>
<u>fine Sand</u>	<u>28</u>	<u>38</u>
<u>Sand</u>	<u>38</u>	<u>54</u>
<u>Sand & Gravel</u>	<u>54</u>	<u>103</u>

WELL LOCATION:
sec 31 T. 20N R. 4E
5 miles W of Alaine
(distance) (direction) (nearest town)

WELL PURPOSE:
(home, irrigation, municipal, industrial)


CODED

WELL COMPLETION DATA:

- (1) diameter (inches) 12"
- (2) total depth (feet) 103'
- (3) static water level (feet) 20' below top of ground.
- (4) casing Steel 43'
(material) (depth)
1 1/2" If telescope see back.
(size)
- (5) screen 40' 63'
(length) (depth to top)
1 1/2" Steel
(size) (material)
- (6) pump _____
(HP) (yield gpm)
(type power)
- (7) electric log No
(yes or no)
(organization running log)
- (8) how well bottom plugged Steel
plate



DRILLERS REMARKS:

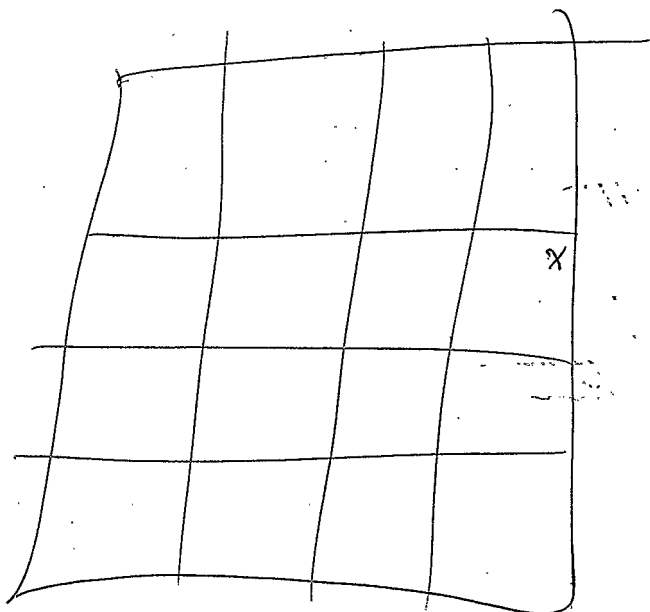

see 2