

Sun Flower
K40

2-20-80

GW 9461

2/20

1980

Dyer
firm name

CODED

Seem.
county well located

MISSISSIPPI
BOARD OF WATER COMMISSIONERS
416 North State Street
Jackson, Mississippi 39201

WATER WELL DRILLERS LOG

LANDOWNER:

BOBBY KIRK

~~MADIA NOLA~~
(mailing address)

WELL LOCATION:

sec. 17 T. 20^N R. 4 E
S
4 miles NW of SUNFLOWER
(distance) (direction) (nearest town)

WELL PURPOSE:

(home, irrigation, municipal, industrial)

WELL COMPLETION DATA:


- (1) diameter (inches) 12"
- (2) total depth (feet) 103'
- (3) static water level (feet) 20' below top of ground.
- (4) casing Steel 103'
(material) (depth)
16" if telescope see back.
(size)
- (5) screen 40' 63'
(length) (depth to top)
16" Steel
(size) (material)
- (6) pump 40 2000
(HP) (yield gpm)
Propane
(type power)
- (7) electric log (yes or no)
- (organization running log)
- (8) how well bottom plugged. plate

description of formations encountered

from to

Clay	0	28
Finl sand	28	38
Sand	38	45
Sand & gravel	45	103


CODED

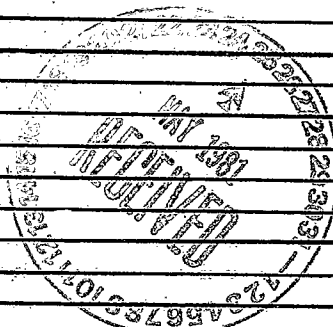

DRILLERS REMARKS:

If well telescopes please sketch and show depths.

GROUND LEVEL

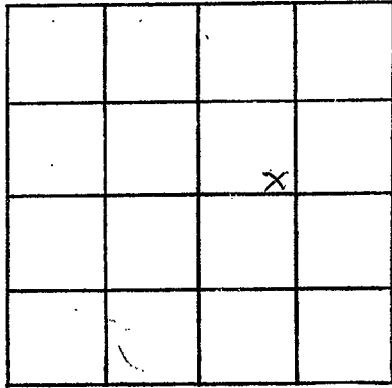

SECTION 17

Please indicate well location X.

ADDITIONAL INFORMATION

If more than one screen,
show locations of each on sketch.