

MISSISSIPPI DEPARTMENT OF NATURAL RESOURCES

Bureau of Land and Water Resources

Southport Mall

P.O. Box 10631

Jackson, Mississippi 39209

WATER WELL DRILLERS LOG

6
CODED

SUNFLOWER
K41
6-5-81

June - 5 1981 Delta well & Supply Sunflower
 date well completed firm name county well located


LANDOWNER:	description of formations encountered	from	to
Walker Powell			
Doddsville Miss (mailing address)	Clay fine sand Course sand - brown	19 30 60	30 65 114

WELL LOCATION:
 sec. 16 T. 30 N. R. 4 E.
 6 miles S.W. of Doddsville
 (distance) (direction) (nearest town)

WELL PURPOSE: Irrigation
 (home, irrigation, municipal, industrial)

- WELL COMPLETION DATA:
- (1) diameter (inches) 16"
 - (2) total depth (feet) 114
 - (3) static water level (feet) 22 below above top of ground.
 - (4) casing Steel (material), (depth), (size) If telescope see back.
 - (5) screen 40 (length), (depth to top) 16" (size), Steel (material)
 - (6) pump 60 (HP), 3000 (yield gpm)
Diesel (type power)
 - (7) electric log No (yes or no)
 - (organization running log)
 - (8) how well bottom plugged Steel plate

DRILLERS REMARKS:

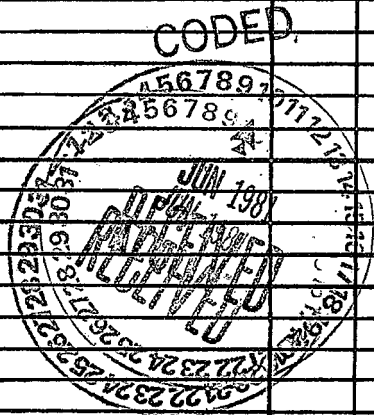


If well telescopes please sketch and show depths.

GROUND LEVEL

Water Level 22 ft

40' - 16" Screen
16" casing

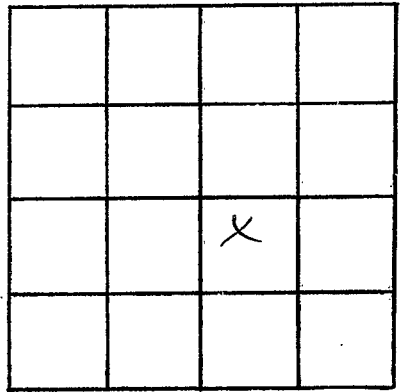

SECTION 16

Please indicate well location X.

ADDITIONAL INFORMATION

If more than one screen, show locations of each on sketch.