

MISSISSIPPI DEPARTMENT OF NATURAL RESOURCES

Bureau of Land and Water Resources

Southport Mall

P.O. Box 10631

Jackson, Mississippi 39209
WATER WELL DRILLERS LOG

CODED

<i>Amflow</i>
K42
6-12-81

June 12 1981 Larry's well & Pump *Amflow*
 date well completed firm name county well located

LANDOWNER: Joe Oglesby
Indianola MS
 (mailing address)

description of formations encountered	from	to
<u>Clay</u>	<u>0</u>	<u>28</u>
<u>fine sand</u>	<u>28</u>	<u>56</u>
<u>Med to coarse</u>	<u>56</u>	<u>113</u>

WELL LOCATION:
 sec. 22 T. 20 N. R. 4 E. W. 8
8 miles N of Indianola
 (distance) (direction) (nearest town)

WELL PURPOSE: Fish Pond
 (home, irrigation, municipal, industrial)

- WELL COMPLETION DATA:
- (1) diameter (inches) 16"
 - (2) total depth (feet) 113'
 - (3) static water level (feet) 20 below top of ground.
 - (4) casing Steel 73'
 (material) (depth)
 (size) if telescope see back.
 - (5) screen 40' 73'
 (length) (depth to top)
16" Steel
 (size) (material)
 - (6) pump _____ (HP) _____ (yield gpm)
 (type power)
 - (7) electric log No
 (yes or no)
 (organization running log)
 - (8) how well bottom plugged Steel Plate


DRILLERS REMARKS:

CODED

DEPT. OF NATURAL RESOURCES
 BUREAU OF LAND & WATER RESOURCES
 JUL 16 1981
 RECEIVED

If well telescopes please sketch and show depths.

GROUND LEVEL

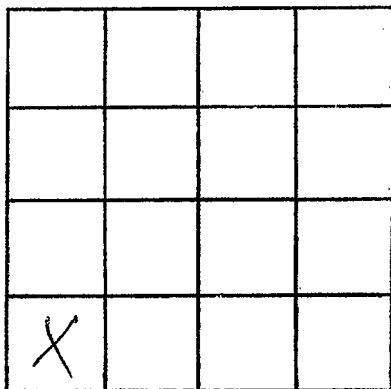

SECTION 22

Please indicate well location X.

ADDITIONAL INFORMATION

If more than one screen, show locations of each on sketch.