

MISSISSIPPI DEPARTMENT OF NATURAL RESOURCES

Bureau of Land and Water Resources

Southport Mall

P.O. Box 10631

Jackson, Mississippi 39209

WATER WELL DRILLERS LOG

18
CODED

Sunflower
K 43
6-12-81

June 12, 1981
date well completed

Larry's well & Pump
firm name

Sunflower
county well located

LANDOWNER: Charles Boyer	description of formations encountered	from	to
Indianola, MS (mailing address)	Clay 70' Sand Med to Course Sand	0 29 60	29 60 116
WELL LOCATION: sec. 22 T 20 N R 4 E 8 miles N of Indianola (distance) (direction) (nearest town)			
WELL PURPOSE: Fish Pond (home, irrigation, municipal, industrial)			
WELL COMPLETION DATA:			
(1) diameter (inches) 16"			
(2) total depth (feet) 116'			
(3) static water level (feet) 26' below top of ground.			
(4) casing Steel, 76' (material) (depth) (size) If telescope see back.			
(5) screen 40' 76' (length) (depth to top) 16" Steel (size) (material)			
(6) pump 60 3000 (HP) (yield gpm)			
(type power)			
(7) electric log NO (yes or no)			
(organization running log)			
(8) how well bottom plugged Steel Plate			
DRILLERS REMARKS:			

CODED

RECEIVED
 8/10/1981 4:17


DEPT. OF NATURAL RESOURCES
BUREAU OF LAND & WATER RESOURCES

OCT 19 1981

RECEIVED

If well telescopes please sketch and show depths.

GROUND LEVEL

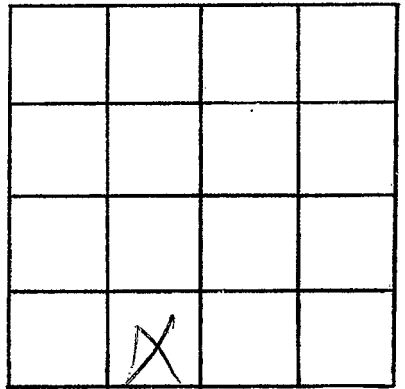

SECTION 202

Please indicate well location X.

ADDITIONAL INFORMATION

If more than one screen,
show locations of each on sketch.