

MISSISSIPPI DEPARTMENT OF NATURAL RESOURCES

Bureau of Land and Water Resources

Southport Mall

P.O. Box 10631

Jackson, Mississippi 39209

CODED

WATER WELL DRILLERS LOG

Surflower  
R 44  
7-1-81

GW 4264

SW/SE, Sec. 33

Elev. 121

date well completed July 01 1981 firm name Larry's Well & Pump Surflower county well located Surflower

LANDOWNER: J. B. Martin

description of formations encountered

from to

Indiana  
(mailing address)

CLAY	0	40
FINE SAND	40	60
COURSE SAND	60	100

WELL LOCATION:

33 34 T. 20 N R. 4 E  
sec. T. R. S. W.  
8 miles N of Indiana  
(distance) (direction) (nearest town)

WELL PURPOSE:

(home, irrigation, municipal, industrial)

WELL COMPLETION DATA:

- (1) diameter (inches) 8"
- (2) total depth (feet) 100'
- (3) static water level (feet) 25 below above top of ground.
- (4) casing Plastic, 60'  
(material) (depth)  
(size) If telescope see back.
- (5) screen 40', 60'  
(length) (depth to top)  
8", Plastic  
(size) (material)
- (6) pump 10 H.P., 700  
(HP) (yield gpm)  
Elec.  
(type power)
- (7) electric log No  
(yes or no)

(organization running log)

- (8) how well bottom plugged Pvc  
cap

DRILLERS REMARKS:


CODED

DEPT. OF NATURAL RESOURCES  
BUREAU OF LAND & WATER RESOURCES

OCT 19 1981  
RECEIVED

If well telescopes please sketch and show depths.

GROUND LEVEL

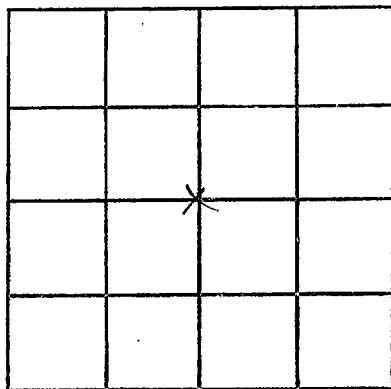

SECTION 34

Please indicate well location X.

ADDITIONAL INFORMATION

If more than one screen,  
show locations of each on sketch.