

MISSISSIPPI DEPARTMENT OF NATURAL RESOURCES

Bureau of Land and Water Resources

Southport Mall

P.O. Box 10631

Jackson, Mississippi 39209

CODED

WATER WELL DRILLERS LOG

John Patton Chism
Irrigation Equipment, Inc.

April 14, 1982
date well completed

firm name

Sunflower
county well located

LANDOWNER:	description of formations encountered	from	to
William Pitts	Clay	0	15'
	Fine Sand	15'	65'
	Coarse sand/gravel	65'	108'
(mailing address)			
WELL LOCATION:			
sec. 33 T-20 (N) R-4 E (W) S W			
1 1/4 miles of Bover (distance) (direction) (nearest town)			
WELL PURPOSE: irrigation (home, irrigation, municipal, industrial)			
WELL COMPLETION DATA:			
(1) diameter (inches) 16"			
(2) total depth (feet) 108'			
(3) static water level (feet) 29' below top of ground.			
(4) casing steel, 68' (material) (depth)			
(size) if telescope see back.			
(5) screen 40' 68' (length) (depth to top)			
16" steel (size) (material)			
(6) pump 150 2000 (HP) (yield gpm)			
Diesel (type power)			
(7) electric log (yes or no)			
(organization running log)			
(8) how well bottom plugged steel plate			

DEPT. OF NATURAL RESOURCES
BUREAU OF LAND & WATER RESOURCES


MAY - 3 1982

RECEIVED

DRILLERS REMARKS:

If well telescopes please sketch and show depths.

GROUND LEVEL

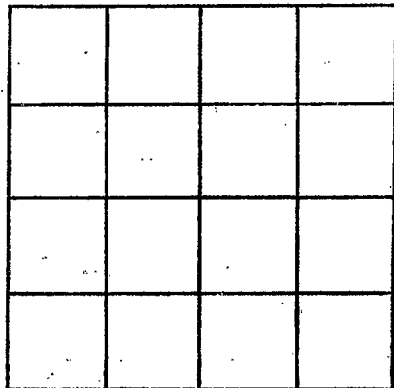

SECTION _____

Please indicate well location X.

ADDITIONAL INFORMATION

If more than one screen, show locations of each on sketch.