

MISSISSIPPI DEPARTMENT OF NATURAL RESOURCES

Bureau of Land and Water Resources

Southport Mall

P.O. Box 10631

Jackson, Mississippi 39209

CODED

WATER WELL DRILLERS LOG

John Patton Chesin
Irrigation Equipment, Inc.

Sunflower

Sunflower
K 48
4/16/82

4/16/82

date well completed

firm name

county well located

LANDOWNER: J. P. Fisher

description of formations encountered

from

to

Clay

0

8'

Fine Sand

8'

62'

Coarse Sand

62'

65'

(mailing address)

Coarse sand/small gravel

65'

70'

WELL LOCATION:

Large gravel/coarse sand

70'

118'

sec. 26 T 20 N 4 E S W

2 1/2 miles North W of Sunflower
(distance) (direction) (nearest town)

WELL PURPOSE: irrigation
(home, irrigation, municipal, industrial)

WELL COMPLETION DATA:

- (1) diameter (inches) 12"
- (2) total depth (feet) 118'
- (3) static water level (feet) 27' below above top of ground.

(4) casing steel 78' 80'
(material) (depth)

(size) if telescope see back.

(5) screen 40' 78'
(length) (depth to top)

12" steel
(size) (material)

(6) pump 60 1300
(HP) (yield gpm)

direct
(type power)

(7) electric log (yes or no)

(organization running log)

(8) how well bottom plugged steel plate

DEPT. OF NATURAL RESOURCES
BUREAU OF LAND & WATER RESOURCES


MAY - 3 1982

RECEIVED

DRILLERS REMARKS:

If well telescopes please sketch and show depths.

GROUND LEVEL

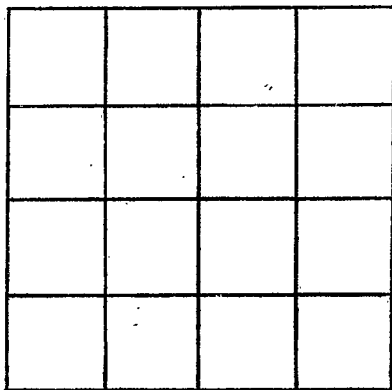

SECTION _____

Please indicate well location X.

ADDITIONAL INFORMATION

If more than one screen,
show locations of each on sketch.