

MISSISSIPPI DEPARTMENT OF NATURAL RESOURCES

Bureau of Land and Water Resources

Southport Mall

P.O. Box 10631

Jackson, Mississippi 39209

WATER WELL DRILLERS LOG **CODED**

*Sunflower*  
*K 49*  
*4/18/82*

4/18/82

Irrigation Equipment, Inc.

Sunflower

date well completed

19

*John Patton Chism*

firm name

county well located

LANDOWNER: J. P. Fisher

description of formations encountered

from

to

Clay

0

9'

Fine Sand

9'

65'

Coarse sand/gravel

65'

120'

(mailing address)

WELL LOCATION:

sec <sup>26</sup> T <sup>20</sup> <sup>(N)</sup> R <sup>4</sup> <sup>(E)</sup>  
<sub>S</sub> <sub>(W)</sub>  
 2 1/2 miles North W of Sunflower  
 (distance) (direction) (nearest town)

WELL PURPOSE: Irrigation  
 (home, irrigation, municipal, industrial)

WELL COMPLETION DATA:

- (1) diameter (inches) 12"
- (2) total depth (feet) 120'
- (3) static water level (feet) 27' <sup>below</sup> <sub>above</sub> top of ground.
- (4) casing steel, 80'  
 (material) (depth)  
 \_\_\_\_\_ if telescope see back.  
 (size)
- (5) screen 40', 80'  
 (length) (depth to top)  
12", steel  
 (size) (material)
- (6) pump 100 1500  
 (HP) (yield gpm)  
Diesel  
 (type power)
- (7) electric log \_\_\_\_\_  
 (yes or no)


(organization running log)

(8) how well bottom plugged steel plate

DRILLERS REMARKS:

If well telescopes please sketch and show depths.

GROUND LEVEL

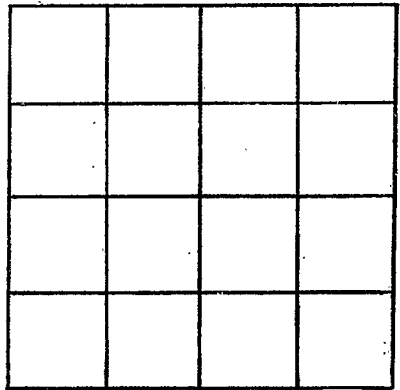

SECTION \_\_\_\_\_

Please indicate well location X.

ADDITIONAL INFORMATION

If more than one screen,  
show locations of each on sketch.