

MISSISSIPPI DEPARTMENT OF NATURAL RESOURCES
Bureau of Land and Water Resources
 Southport Mall
 P.O. Box 10631
 Jackson, Mississippi 39209
WATER WELL DRILLERS LOG

CODED

Sunflower
K 50
3/25/82

March 25 1982 Larry's well & pump Sunflower
 date well completed firm name county well located

LANDOWNER: W. Pitts

description of formations encountered from to

Indianola, Mo.
 (mailing address)

clay 0 20
med Sand 20 40
coarse Sand 40 100

WELL LOCATION:
 sec. 21 T. 20 N R. 4 E
 S W
7 miles North of Indianola
 (distance) (direction) (nearest town)

WELL PURPOSE:
 (home, irrigation, municipal, industrial)

WELL COMPLETION DATA:

- (1) diameter (inches) 8"
- (2) total depth (feet) 100'
- (3) static water level (feet) 21 below above top of ground.
- (4) casing PVC, 60'
 (material) (depth)
 _____ if telescope see back.
 (size)
- (5) screen 40' 60'
 (length) (depth to top)
8" PVC
 (size) (material)
- (6) pump 10 H.P. 700
 (HP) (yield gpm)
Elec.
 (type power)
- (7) electric log No
 (yes or no)

 (organization running log)
- (8) how well bottom plugged PVC
cap

DRILLERS REMARKS:


DEPT. OF NATURAL RESOURCES
 BUREAU OF LAND & WATER RESOURCES

JUN 21 1982

RECEIVED

If well telescopes please sketch and show depths.

GROUND LEVEL

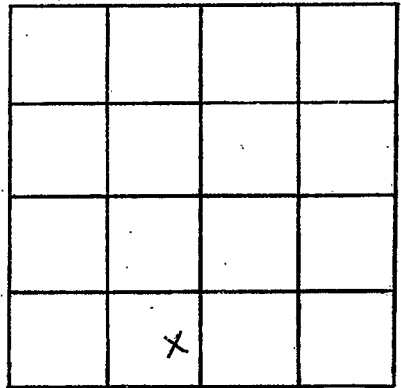

SECTION 21

Please indicate well location X.

ADDITIONAL INFORMATION

If more than one screen,
show locations of each on sketch.