

MISSISSIPPI DEPARTMENT OF NATURAL RESOURCES

Bureau of Land and Water Resources

Southport Mall

P.O. Box 10631

Jackson, Mississippi 39209

WATER WELL DRILLERS LOG

CODED

Amflower  
K 5  
5/19/82

5/19 1982  
 date well completed

Larvin's well & pump  
 firm name

Amflower  
 county well located

LANDOWNER: Edgar Donahoe

description of formations encountered

from

to

Indianola, Ms  
 (mailing address)

<u>slay</u>	<u>0</u>	<u>20</u>
<u>fine sand</u>	<u>20</u>	<u>30</u>
<u>med. S</u>	<u>30</u>	<u>50</u>
<u>coarse sand &amp; gravel</u>	<u>50</u>	<u>100</u>

WELL LOCATION:

sec. 30 T 20 N R. 4 E  
 S W  
6 miles North of Indianola  
 (distance) (direction) (nearest town)

WELL PURPOSE:

(home, irrigation, municipal, industrial)

WELL COMPLETION DATA:

- (1) diameter (inches) 10"
- (2) total depth (feet) 100
- (3) static water level (feet) 25 below above top of ground.
- (4) casing Steel, 60  
 (material) (depth)  
 (size) If telescope see back.
- (5) screen 40, 60  
 (length) (depth to top)  
10", Steel  
 (size) (material)
- (6) pump 20, 1000  
 (HP) (yield gpm)  
Gas  
 (type power)
- (7) electric log No.  
 (yes or no)

(organization running log)

- (8) how well bottom plugged Steel Plate

DEPT. OF NATURAL RESOURCES  
 BUREAU OF LAND & WATER RESOURCES


SEP 15 1982

RECEIVED

DRILLERS REMARKS:

If well telescopes please sketch and show depths.

GROUND LEVEL

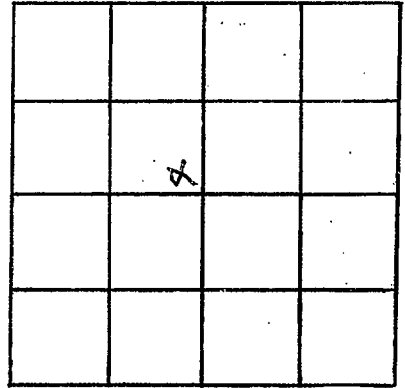

SECTION 30

Please indicate well location X.

ADDITIONAL INFORMATION

If more than one screen,  
show locations of each on sketch.