

MISSISSIPPI DEPARTMENT OF NATURAL RESOURCES

Bureau of Land and Water Resources

Southport Mall

P.O. Box 10631

Jackson, Mississippi 39209

CODED

WATER WELL DRILLERS LOG

*Shuffler*  
 K 55  
 6/14/82

GW 6037  
 SW/NE, Sec. 23  
 Elev. 120

6/14, 1982 *Dyer Well*

*Shuffler*  
 county well located

date well completed

firm name

county well located

LANDOWNER: *Dyer*

description of formations encountered

from

to

(mailing address)

|               |    |     |
|---------------|----|-----|
| Clay          | 0  | 20  |
| Fin. Sand     | 20 | 66  |
| Sand & Gravel | 66 | 108 |

WELL LOCATION:

sec. 23 T 20 N R 4 E  
 S W  
8 miles NE of Indianola  
 (distance) (direction) (nearest town)

WELL PURPOSE:

(home, irrigation, municipal, industrial)

WELL COMPLETION DATA:

- (1) diameter (inches) 10
- (2) total depth (feet) 108
- (3) static water level (feet) 13 below above top of ground.
- (4) casing Steel 68  
 (material) (depth)
- 10  
 (size) if telescope see back.
- (5) screen 40 68  
 (length) (depth to top)
- 10 in. steel  
 (size) (material)
- (6) pump 1.5 800  
 (HP) (yield gpm)
- electric  
 (type power)
- (7) electric log No  
 (yes or no)

(organization running log)

(8) how well bottom plugged Plate

DEPT. OF NATURAL RESOURCES  
 BUREAU OF LAND & WATER RESOURCES


SEP 30 1982

RECEIVED

DRILLERS REMARKS:

If well telescopes please sketch and show depths.

GROUND LEVEL

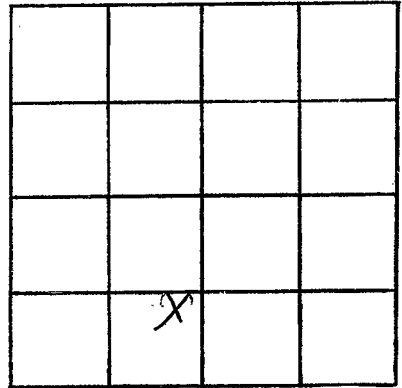

SECTION 20

Please indicate well location X.

ADDITIONAL INFORMATION

If more than one screen,  
show locations of each on sketch.