

MISSISSIPPI DEPARTMENT OF NATURAL RESOURCES

Bureau of Land and Water Resources

Southport Mall

P.O. Box 10631

Jackson, Mississippi 39209

WATER WELL DRILLERS LOG

CODED

*Jeff Lawver*  
R 56  
7/21/82

July 21, 82 19 *Dejea Well Dr Inc* *Jeff Lawver*  
date well completed firm name county well located

LANDOWNER:  
*Charles McClintey*  
(mailing address)

description of formations encountered	from	to
<i>Clay</i>	<i>0</i>	<i>12</i>
<i>Fine sand</i>	<i>12</i>	<i>20</i>
<i>Sand</i>	<i>20</i>	<i>26</i>
<i>Sand &amp; gravel</i>	<i>26</i>	<i>110</i>

WELL LOCATION:  
sec. *20* T. *20* S. R. *40* E.  
*5* miles *N* of *Inchard*  
(distance) (direction) (nearest town)

WELL PURPOSE: *Irrigation*  
(home, irrigation, municipal, industrial)

WELL COMPLETION DATA:

(1) diameter (inches) *12*

(2) total depth (feet) *20 110*

(3) static water level (feet) *24* below top of ground.

(4) casing *STEEL* *20*  
(material) (depth)

*12* if telescope see back.  
(size)

(5) screen *40* *110*  
(length) (depth to top)

(size) (material)

(6) pump *1.5* *1000*  
(HP) (yield gpm)

*diesel*  
(type power)

(7) electric log *N*  
(yes or no)

(organization running log)

(8) how well bottom plugged  
*Steel plate*


DRILLERS REMARKS:

DEPT. OF NATURAL RESOURCES  
BUREAU OF LAND & WATER RESOURCES

SEP 30 1982  
RECEIVED

If well telescopes please sketch and show depths.

GROUND LEVEL

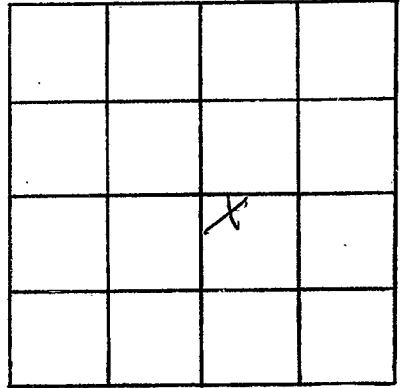

SECTION 20

Please indicate well location X.

ADDITIONAL INFORMATION

If more than one screen, show locations of each on sketch.