

MISSISSIPPI DEPARTMENT OF NATURAL RESOURCES

Bureau of Land and Water Resources

Southport Mall

P.O. Box 10631

Jackson, Mississippi 39209

WATER WELL DRILLERS LOG

CODED

SUNFLOWER
K 58
3/29/1983

March 29 1983 date well completed
Larrin's well x pump firm name
Sunflower county well located

LANDOWNER: <u>art clark</u>	description of formations encountered	from	to
(mailing address)	<u>clay</u>	<u>0</u>	<u>30</u>
WELL LOCATION: sec. <u>34</u> <u>20</u> T <u>N</u> R <u>E</u> S <u>S</u> W <u>4</u>	<u>Sand</u>	<u>30</u>	<u>85</u>
<u>11</u> miles <u>North</u> of <u>Independence</u> (distance) (direction) (nearest town)	<u>Sand & gravel</u>	<u>85</u>	<u>130</u>
WELL PURPOSE: (home, irrigation, municipal, industrial)			
WELL COMPLETION DATA:			
(1) diameter (inches) <u>16"</u>			
(2) total depth (feet) <u>130'</u>			
(3) static water level (feet) <u>24'</u> below above top of ground.			
(4) casing <u>steel</u> , <u>90'</u> (material) (depth)			
_____ if telescope see back. (size)			
(5) screen <u>40'</u> , <u>90'</u> (length) (depth to top)			
<u>16"</u> , <u>Steel</u> (size) (material)			
(6) pump _____ (HP) (yield gpm)			
(type power)			
(7) electric log <u>NO</u> (yes or no)			
(organization running log)			
(8) how well bottom plugged <u>Steel Plate</u>			
DRILLERS REMARKS:			

CODED

DEPT. OF NATURAL RESOURCES
BUREAU OF LAND & WATER RESOURCES


MAY 5 - 1983

RECEIVED

If well telescopes please sketch and show depths.

GROUND LEVEL

2000

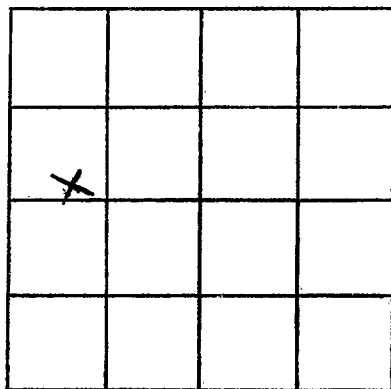

SECTION 34

Please indicate well location X.

ADDITIONAL INFORMATION

If more than one screen,
show locations of each on sketch.