

MISSISSIPPI DEPARTMENT OF NATURAL RESOURCES

Bureau of Land and Water Resources

Southport Mall

P.O. Box 10631

Jackson, Mississippi 39209

WATER WELL DRILLERS LOG

CODED

SWINFLOWER

159

8/19/83

Aug. 9, 1983
date well completed

Dyer Well & Irrigation
firm name

Swflower
county well located

LANDOWNER:	description of formations encountered	from	to
<p>Goe Oglesby Indianola, Miss. 38751 (mailing address)</p>	<p>Clay Fine Sand Sand & gravel</p>	<p>0 38 68</p>	<p>35 68 110</p>
<p>WELL LOCATION: sec. <u>21</u> T <u>20</u> (N) R <u>4</u> (E) <u>4</u> miles North of Indianola (distance) (direction) (nearest town)</p>			
<p>WELL PURPOSE: <u>Irrigation</u> (home, irrigation, municipal, industrial)</p>			
<p>WELL COMPLETION DATA:</p>			
<p>(1) diameter (inches) <u>16"</u></p>			
<p>(2) total depth (feet) <u>110'</u></p>			
<p>(3) static water level (feet) <u>26'</u> below top of ground.</p>			
<p>(4) casing <u>Steel</u>, <u>70'</u> (material) (depth) <u>16"</u> if telescope see back. (size)</p>			
<p>(5) screen <u>40'</u>, <u>70'</u> (length) (depth to top) <u>16"</u>, <u>Mild Steel</u> (size) (material)</p>			
<p>(6) pump <u>60</u>, <u>3,000</u> (HP) (yield gpm)</p>			
<p><u>Diesel</u> (type power)</p>			
<p>(7) electric log <u>No</u> (yes or no)</p>			
<p>(organization running log)</p>			
<p>(8) how well bottom plugged <u>Plugs</u></p>			
<p>DRILLERS REMARKS:</p>			

CODED


DEPT. OF NATURAL RESOURCES
BUREAU OF LAND & WATER RESOURCES

DEC - 7 1983

RECEIVED

If well telescopes please sketch and show depths.

GROUND LEVEL

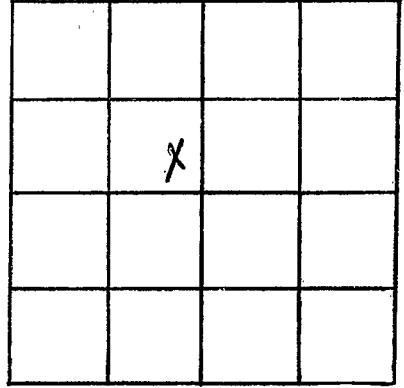

SECTION 21

Please indicate well location X.

ADDITIONAL INFORMATION

If more than one screen,
show locations of each on sketch.