

MISSISSIPPI DEPARTMENT OF NATURAL RESOURCES

Bureau of Land and Water Resources

Southport Mall

P.O. Box 10631

Jackson, Mississippi 39209

WATER WELL DRILLERS LOG

CODED

SUNFLOWER
K 60
8/11/83

Aug. 11, 1983 Dyer Well + Irrigation Sunflower
date well completed firm name county well located

LANDOWNER: Charles McClatchy	description of formations encountered	from	to
Indianola, Miss. (mailing address)	Clay	0	20
WELL LOCATION:	Fine Sand	20	48
sec. 29 T. 20 (N) S R. 4 E W 6 miles North of Indianola (distance) (direction) (nearest town)	Sand	42	54
WELL PURPOSE: Irrigation (home, irrigation, municipal, industrial)	Sand + Gravel	54	113
WELL COMPLETION DATA:	CODED		
(1) diameter (inches) 16"			
(2) total depth (feet) 113'			
(3) static water level (feet) 23' below top of ground.			
(4) casing Steel 73' (material) (depth) 16" (size) if telescope see back.			
(5) screen 40' 73' (length) (depth to top)			
(6) pump 16 Mild Steel (size) (material)			
(7) pump 40 2000 (HP) (yield gpm)			
Desel (type power)			
(8) electric log No (yes or no)			
(organization running log)			
(8) how well bottom plugged Plate			
DRILLERS REMARKS:			


DEPT. OF NATURAL RESOURCES
BUREAU OF LAND & WATER RESOURCES

DEC - 7 1983

RECEIVED

If well telescopes please sketch and show depths.

GROUND LEVEL

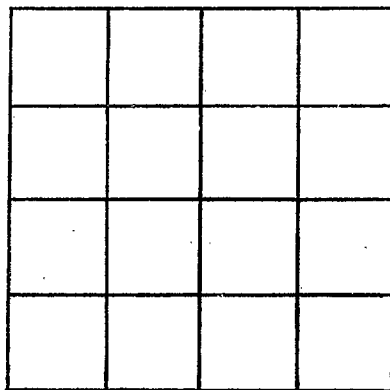

SECTION _____

Please indicate well location X.

ADDITIONAL INFORMATION

If more than one screen,
show locations of each on sketch.