

MISSISSIPPI DEPARTMENT OF NATURAL RESOURCES

Bureau of Land and Water Resources

Southport Mall

P.O. Box 10631

Jackson, Mississippi 39209

WATER WELL DRILLERS LOG

CODED

SUNFLOWER
K 62

June 06 1984 date well completed Larry's wells pump firm name Sunflower county well located

LANDOWNER: William Pitts

description of formations encountered

from to

Indianola Miss.
(mailing address)

<u>clay</u>	0	30
<u>fine sand</u>	30	80
<u>coarse sand & gra</u>	50	1000

WELL LOCATION:

sec. 17 T. 20 N S R. 4 E W
8 miles N of Indianola
 (distance) (direction) (nearest town)

CODED

WELL PURPOSE:

(home, irrigation, municipal, industrial)

WELL COMPLETION DATA:

- (1) diameter (inches) 12"
- (2) total depth (feet) 100'
- (3) static water level (feet) 22 below above top of ground.
- (4) casing Steel, 60'
 (material) (depth)
 (size) if telescope see back.
- (5) screen 40', 60'
 (length) (depth to top)
12", Steel
 (size) (material)
- (6) pump 40 700
 (HP) (yield gpm)
- D
 (type power)
- (7) electric log No
 (yes or no)

DEPT. OF NATURAL RESOURCES
 BUREAU OF LAND & WATER RESOURCES

OCT - 2 1984

RECEIVED


(organization running log)

(8) how well bottom plugged Steel Plate

DRILLERS REMARKS:

If well telescopes please sketch and show depths.

GROUND LEVEL

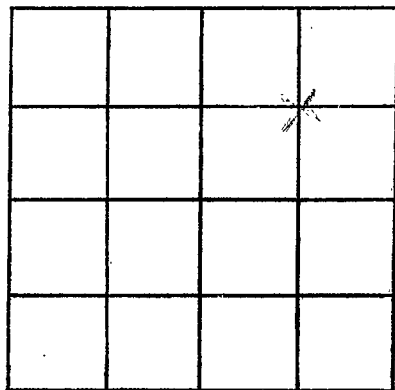

SECTION 17

Please indicate well location X.

ADDITIONAL INFORMATION

If more than one screen,
show locations of each on sketch.