

MISSISSIPPI DEPARTMENT OF NATURAL RESOURCES

Bureau of Land and Water Resources

Southport Mall

P.O. Box 10631

Jackson, Mississippi 39209

WATER WELL DRILLERS LOG

CODED

GW 10478

NE/SE, Sec. 12

Elev. 122

K63
 SUNFLOWER
 6-12-84

19 Super Well firm name Sunflower county well located

LANDOWNER:	description of formations encountered	from	to
<u>Kerner Acant</u> (mailing address)	<u>Clay</u>	<u>0</u>	<u>28</u>
WELL LOCATION:	<u>Hard Sand</u>	<u>28</u>	<u>34</u>
sec. <u>12</u> T. <u>2D</u> (N) S R. <u>4</u> E (W)	<u>Sand</u>	<u>44</u>	<u>58</u>
<u>2.2</u> miles <u>S.W</u> of <u>Blaine</u> (distance) (direction) (nearest town)	<u>Sand & Gravel</u>	<u>55</u>	<u>111</u>
WELL PURPOSE: (home, irrigation, municipal, industrial)	CODED		
WELL COMPLETION DATA:			
(1) diameter (inches) <u>16"</u>			
(2) total depth (feet) <u>111</u>			
(3) static water level (feet) <u>24</u> ^{below} / _{above} top of ground.			
(4) casing <u>STEEL</u> , <u>71</u> (material) (depth) <u>16</u> (size) if telescope see back.			
(5) screen <u>40</u> , <u>71</u> (length) (depth to top)			
(6) pump <u>16</u> , <u>STEEL</u> (size) (material)			
(7) pump <u>1/2</u> <u>1000</u> (HP) (yield gpm)			
(type power) <u>Dies</u>			
(7) electric log <u>No.</u> (yes or no)			
(organization running log) <u>No.</u>			
(8) how well bottom plugged <u>STEEL PLATE</u>			


CODED

1-14-85
 JAC

DRILLERS REMARKS:
Catfish Ponds.

If well telescopes please sketch and show depths.

GROUND LEVEL

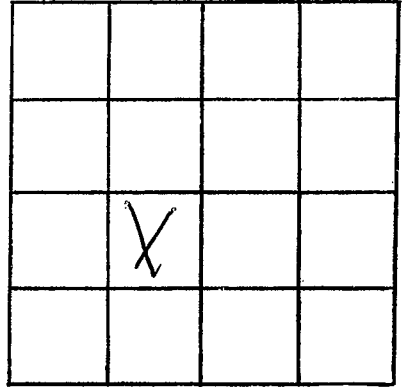

SECTION 12

Please indicate well location X.

ADDITIONAL INFORMATION

If more than one screen,
show locations of each on sketch.