

MISSISSIPPI DEPARTMENT OF NATURAL RESOURCES

Bureau of Land and Water Resources

Southport Mall

P.O. Box 10631

Jackson, Mississippi 39209

WATER WELL DRILLERS LOG

CODED

K164
Sunflower
6-12-84

GW 10479
SE/NE, Sec. 12
Elev. 123

19 Dye Well firm name Sunflower county well located


LANDOWNER:	description of formations encountered	from.	to
<u>Turner Acant</u> (mailing address)	<u>Clay</u> <u>And Sand</u>	<u>0</u>	<u>28</u> <u>38</u>
WELL LOCATION: sec. <u>12</u> T <u>20</u> N R <u>4</u> E <u>3</u> miles <u>S-W</u> of <u>Blaine</u> (distance) (direction) (nearest town)	<u>Sand</u> <u>Sand + Gravel</u>	<u>38</u> <u>49</u>	<u>45</u> <u>100</u>
WELL PURPOSE: (home, irrigation, municipal, industrial)			
WELL COMPLETION DATA:			
(1) diameter (inches) <u>16</u>			
(2) total depth (feet) <u>110</u>			
(3) static water level (feet) <u>28</u> below above top of ground.			
(4) casing <u>STEEL</u> <u>70</u> (material) (depth) <u>16</u> If telescope see back. (size)			
(5) screen <u>10ft</u> <u>70</u> (length) (depth to top) <u>16</u> <u>STEEL</u> (size) (material)			
(6) pump <u>50</u> <u>2000</u> (HP) (yield gpm) <u>Dies</u> (type power)			
(7) electric log <u>No</u> (yes or no) <u>No</u> (organization running log)			
(8) how well bottom plugged <u>STEEL PLATE</u>			
DRILLERS REMARKS: <u>Replaced well.</u>			

CODED

1-16-85
M-C

If well telescopes please sketch and show depths.

GROUND LEVEL

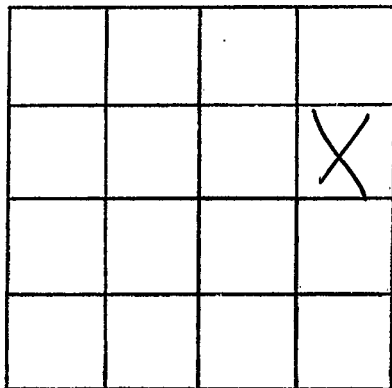

SECTION 12

Please indicate well location X.

ADDITIONAL INFORMATION

If more than one screen,
show locations of each on sketch.