

MISSISSIPPI DEPARTMENT OF NATURAL RESOURCES

Bureau of Land and Water Resources

Southport Mall

P.O. Box 10631

Jackson, Mississippi 39209

WATER WELL DRILLERS LOG

Permit Applied For K 67

5-10 date well completed

1988 Dyer Well firm name

Sunflower county well located

LANDOWNER: Mrs. S.T. Brown

2501 Lazy Hollow Dr.  
Apt 226B Houston TX 77063  
(mailing address)

description of formations encountered

	from	to
Clay	0	28
Fine Sand	28	40
M Sand & Gravel	40	65
Sand & Gravel	65	103

WELL LOCATION:

sec 31 T 20 N R 4 E  
6 miles N of Indianola  
(distance) (direction) (nearest town)

WELL PURPOSE: Irrigation  
(home, irrigation, municipal, industrial)

WELL COMPLETION DATA:

- (1) diameter (inches) 10"
- (2) total depth (feet) 103'
- (3) static water level (feet) \_\_\_\_\_ below top of grounds
- (4) casing steel (material), (depth) \_\_\_\_\_  
10" if telescope see back. (size)
- (5) screen 40' (length), (depth to top) \_\_\_\_\_  
10" (size) (material)
- (6) pump 15 (HP) (yield gpm) \_\_\_\_\_  
Elec (type power)
- (7) electric log No (yes or no)  
None (organization running log)
- (8) how well bottom plugged Plate

RECEIVED


JUN 06 1988

Department of Natural Resources  
Bureau of Land & Water Resources

DRILLERS REMARKS:

If well telescopes please sketch and show depths.

GROUND LEVEL

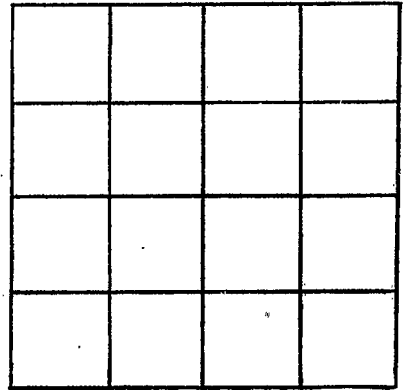

SECTION \_\_\_\_\_

Please indicate well location X.

ADDITIONAL INFORMATION

If more than one screen,  
show locations of each on sketch.