

**CODED**

**MISSISSIPPI DEPARTMENT OF NATURAL RESOURCES**

Bureau of Land and Water Resources

COUNTY WELL LOCATED  
**SUNFLOWER**

WELL NUMBER **K 68**      CODED

DATE WELL COMPLETED  
**6-18-88**

PERMIT NUMBER

NAME OF DRILLING FIRM  
**IRRIGATION EQUIPMENT**

**601/887-2555**

**INDIANOLA, MS**

P.O. Box 10631  
Jackson, Mississippi 39209  
WATER WELL DRILLERS LOG

NAME & MAILING ADDRESS OF LANDOWNER  
**Beulah Land Company**

**Rt. 1, BOX 1-B**

**SUNFLOWER, MS 38778**

WELL LOCATION:      SEC      TOWNSHIP      RANGE  
**26      20      N      4      W**

DISTANCE      DIRECTION      NEAREST TOWN  
**2      Miles      West      of      Sunflower**

OTHER LANDMARK

WELL PURPOSE: Home, Irrigation, Municipal, Industrial, Fish Pond, etc.  
**IRRIGATION - PIVOT**

**PUMP DATA**

PUMP TYPE (Circle One):  
Submersible, **Turbine**      Jet      Flowing Well,  
Other (Describe) \_\_\_\_\_

POWER TYPE (Circle One):  
Electric, Tractor, **Diesel**      Gasoline,      Butane,  
Other (Describe) \_\_\_\_\_      H/P **80**

Pump Capacity (GPM)	No. of Stages	Setting Depth
<b>1400</b>	<b>3</b>	<b>50</b> FT.

PUMP TEST

Well yielded \_\_\_\_\_ GPM with  
a drawdown of \_\_\_\_\_ ft.  
after \_\_\_\_\_ hours of pumping

**WELL DATA**

Well Depth <b>108'</b>	Casing Diameter (In.) <b>12</b>	Casing Length (Ft.) <b>68'</b>
Type of Casing <b>steel</b>	Hole Depth <b>108'</b>	Depth to Static Water Level <b>30'</b>

TYPE OF COMPLETION: (Circle One or More):  
**Gravel Packed**,      Underreamed,      Telescoped,  
Natural Development,      Open Hole,      Other

Top of Lap Pipe or Reduction in Casing

FEET      IF TELESCOPED OR MORE THAN ONE SCREEN: USE BACK PAGE

**LOG DATA**

TYPE OF LOG RUN (Circle One):      No Log Run,  
Electric, Gamma Ray, Density, Sonic, Neutron,  
Other (Describe) \_\_\_\_\_

Name of Organization Running Log


**SCREEN DATA**

Diameter - Inches <b>12</b>	Length - Feet <b>40</b>	Slot Size - Inches <b>.060</b>
Screen Type <b>steel</b>	Depth to Bottom - Feet <b>40</b>	

**GEOLOGIC DATA (Office Use Only)**

Surface Elev.	Geologic Unit	Unit Thickness	Depth to Top
Subs. SWL	Date	Analysis	Aquifer Test

Driller's Remarks

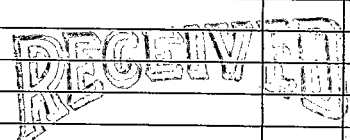
DESCRIPTION OF FORMATIONS ENCOUNTERED	FROM	TO	FORMATIONS (Continued)	FROM	TO
<b>SANDY LOAM</b>	<b>0</b>	<b>10</b>	 <b>JUL 25 1988</b> Department of Natural Resources Bureau of Land & Water		
<b>FINE SAND</b>	<b>10</b>	<b>18</b>			
<b>COARSE SAND</b>	<b>18</b>	<b>61</b>			
<b>COARSE SAND with GRAVEL</b>	<b>61</b>	<b>108</b>			

IF MORE SPACE IS NEEDED, USE BACK

If well telescopes please  
sketch and show depths.

IRRIGATION EQUIPMENT  
601/837-2555  
INDIANOLA, MS

GROUND LEVEL

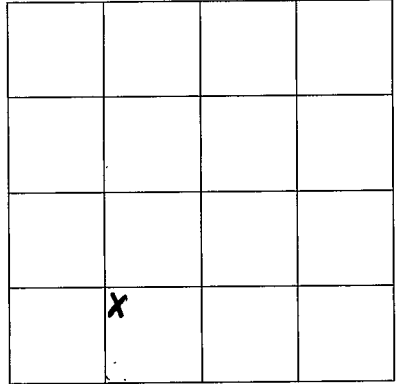

SECTION 26

Please indicate well location X.

ADDITIONAL INFORMATION

If more than one screen,  
show location of each on sketch.