

MISSISSIPPI DEPARTMENT OF NATURAL RESOURCES

Bureau of Land and Water Resources

Southport Mall

P.O. Box 10631

Jackson, Mississippi 39209

WATER WELL DRILLERS LOG

CODED

Sunflower
K 79
5/29/85

BUTANE GAS COMPANY
OF GREENWOOD

Sunflower
county well located

5-29
date well completed

LANDOWNER:
John Britt
Indianola, Miss
(mailing address)

| description of formations encountered | from | to |
|---------------------------------------|------|-----|
| bluy | 0 | 10 |
| sand | 10 | 65 |
| some pea gravel | 65 | 103 |

WELL LOCATION:
sec. 30 T 20 N R 4 E
6 3/4 miles N of Indianola
(distance) (direction) (nearest town)

WELL PURPOSE: Fuel tank
(home, irrigation, municipal, industrial)

- WELL COMPLETION DATA:
- (1) diameter (inches) 16"
 - (2) total depth (feet) 103
 - (3) static water level (feet) 20' below above top of ground.
 - (4) casing STEEL, 63' (material) (depth)
16" (size) if telescope see back.
 - (5) screen 40' 63' (length) (depth to top)
16" steel (size) (material)
 - (6) pump 40 (HP) 2000 (yield gpm)
Diesel (type power)
 - (7) electric log No (yes or no)
No (organization running log)
 - (8) how well bottom plugged steel plate

DRILLERS REMARKS:
Richard Vest

RECEIVED


JUN -4 1985

Department of Natural Resources
Bureau of Land & Water Resources

If well telescopes please sketch and show depths.

GROUND LEVEL

[Faint handwritten notes]

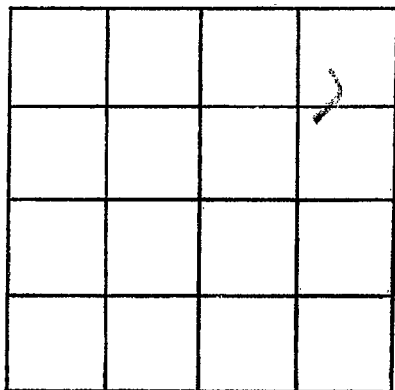

SECTION 50

Please indicate well location X.

ADDITIONAL INFORMATION

If more than one screen, show locations of each on sketch.