

MISSISSIPPI DEPARTMENT OF NATURAL RESOURCES
 Bureau of Land and Water Resources
 Southport Mall
 P.O. Box 10631
 Jackson, Mississippi 39209
WATER WELL DRILLERS LOG

CODED

Sunflower
 481
 4-29-86

4-29-86 19 IRRigation Equipment SUNFLOWER
 date well completed firm name county well located

LANDOWNER: Dyche Plantation
Rt. 1, BOX B-1
SUNFLOWER, MS 38778
 (mailing address)

description of formations encountered	from	to
clay	0	15
Fine sand	15	25
COARSE SAND / GRAVEL	25	105

WELL LOCATION:
 sec. 1 T 20N R 4 E
4 miles West of Blaine
 (distance) (direction) (nearest town)

CODED

WELL PURPOSE: Fish ponds
 (home, irrigation, municipal, industrial)

WELL COMPLETION DATA:

- (1) diameter (inches) 10"
- (2) total depth (feet) 105
- (3) static water level (feet) 30 below above top of ground.
- (4) casing STEEL, 65'
 (material) (depth)
10" if telescope see back.
 (size)
- (5) screen 40', 65'
 (length) (depth to top)
10", STEEL
 (size) (material)
- (6) pump 25, 1200
 (HP) (yield gpm)
Electric
 (type power)
- (7) electric log NO
 (yes or no)
- (organization running log) STEEL PLATE
- (8) how well bottom plugged

RECEIVED

JUN 12 1986


Department of Natural Resources
 Bureau of Land & Water Resources

DRILLERS REMARKS:
#86118 DSB01

If well telescopes please sketch and show depths.

IRRIGATION EQUIPMENT
601/887-2555
INDIANOLA, MS

GROUND LEVEL

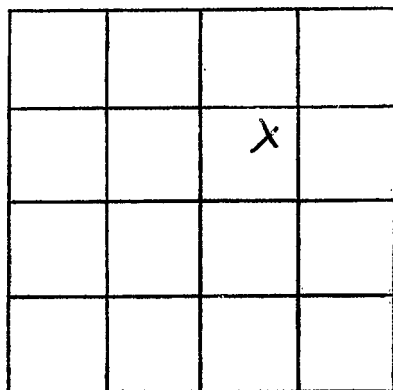

SECTION 1

Please indicate well location X.

ADDITIONAL INFORMATION

If more than one screen,
show locations of each on sketch.