

MISSISSIPPI DEPARTMENT OF NATURAL RESOURCES

Bureau of Land and Water Resources

Southport Mall

P.O. Box 10631

Jackson, Mississippi 39209

WATER WELL DRILLERS LOG

CODED

Sunflower
K 82
4-30-86

4-30-86 19 Irrigation Equipment Sunflower
 date well completed firm name county well located

LANDOWNER: <u>Dyche Plantation</u> <u>Rt. 1, Box B-1</u>	description of formations encountered	from	to
<u>Sunflower, MS 38778</u> (mailing address)	<u>Clay</u>	<u>0</u>	<u>15</u>
	<u>Fine sand</u>	<u>15</u>	<u>25</u>
	<u>Coarse sand / pea gravel</u>	<u>25</u>	<u>105</u>
WELL LOCATION: sec. <u>1</u> T <u>20</u> (N) R <u>4</u> E S (W) <u>4</u> miles <u>West</u> of <u>Blaine</u> (distance) (direction) (nearest town)			
WELL PURPOSE: <u>FISH POND</u> (home, irrigation, municipal, industrial)			
WELL COMPLETION DATA: (1) diameter (inches) <u>10"</u> (2) total depth (feet) <u>105</u> (3) static water level (feet) <u>30</u> ^{below} / _{above} top of ground. (4) casing <u>STEEL</u> <u>65'</u> (material) (depth) <u>10"</u> if telescope see back. (size) (5) screen <u>40'</u> <u>65'</u> (length) (depth to top) <u>10"</u> <u>STEEL</u> (size) (material) (6) pump <u>25</u> <u>1200</u> (HP) (yield gpm) <u>Electric</u> (type power) (7) electric log <u>NO</u> (yes or no) (organization running log) (8) how well bottom plugged <u>Steel</u> <u>PLATE</u>			

CODED

RECEIVED
 JUN 12 1986


Department of Natural Resources
 Bureau of Land & Water Resources

DRILLERS REMARKS:
86118 DSB 02

If well telescopes please sketch and show depths.

IRRIGATION EQUIPMENT.
601/887-2555
INDIANOLA, MS

GROUND LEVEL

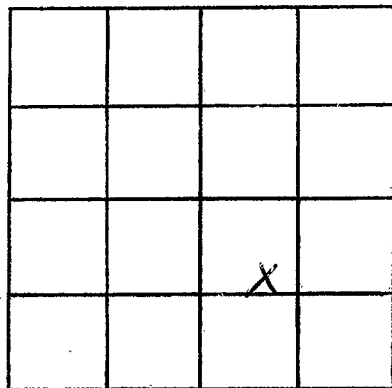

SECTION 1

Please indicate well location X.

ADDITIONAL INFORMATION

If more than one screen,
show locations of each on sketch.