

MISSISSIPPI DEPARTMENT OF NATURAL RESOURCES

Bureau of Land and Water Resources

Southport Mall

P.O. Box 10631

Jackson, Mississippi 39209

WATER WELL DRILLERS LOG

SUNFLOWER
K 83

CODED

7-12-86 19 IRRIGATION EQUIPMENT SUNFLOWER
date well completed firm name county well located

LANDOWNER: Dyche Plantation
Rt. 1, Box B-1
SUNFLOWER, MS 38778
(mailing address)

description of formations encountered	from	to
clay	0	15
FINE SAND	15	35
COARSE SAND / pea gravel	35	100

WELL LOCATION:
sec. 1 T. 20 N. R. 4 E.
4 miles west of BLAINE
(distance) (direction) (nearest town)

WELL PURPOSE: FISH PONDS
(home, irrigation, municipal, industrial)

WELL COMPLETION DATA:

(1) diameter (inches) 10"

(2) total depth (feet) 100

(3) static water level (feet) 30 below above top of ground.

(4) casing steel 60'
(material) (depth)
10"
(size) If telescope see back.

(5) screen 40' 60'
(length) (depth to top)
10" STEEL
(size) (material)


(6) pump 25 1200
(HP) (yield gpm)
Electric
(type power)

(7) electric log NO
(yes or no)

(organization running log)

(8) how well bottom plugged STEEL PLATE

CODED

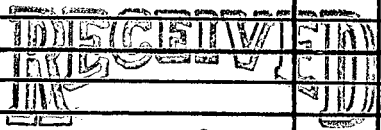

AUG 8 1986


Department of Natural Resources
Bureau of Land & Water Resources

DRILLERS REMARKS:
86118 DSB03

If well telescopes please
sketch and show depths.

IRRIGATION EQUIPMENT
601/837-2555
INDIANOLA, MS

GROUND LEVEL

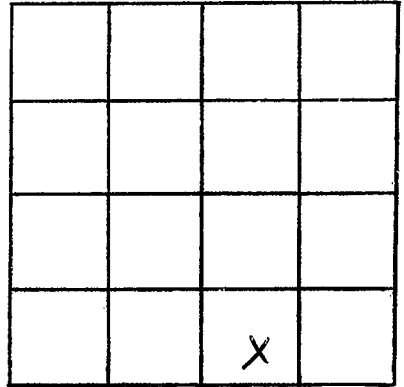

SECTION 1

Please indicate well location X.

ADDITIONAL INFORMATION

If more than one screen,
show locations of each on sketch.