	1 State V	Vell Report	T OT U O L
County:Sunflower	Part 1		For Office Use Only:
Permit # 6 W 41172	Mississippi Department of Environmental Quality		Aquifer:
Irrigation Equipment		and Water Resources Box 10631	well #: K~115
Driller:		MS 39289-0631	L. S. Elevation:
Date drilling completed: $6-14-06$	(601)961-5210 54 (028 (form)	E-log #:
	(601)354-6938 (fax)		E-tog #.
State Law requires that this rep		e driller in detail and filed w	ith the Department within
30 days of completion of drilling Well Owner Inform		Wel	Location
Owner Name Klondike Farm		Lantude:	7. Longitude: 90. 38, 55
Mailing Address: C/O Perry	Maloney	Method of Lat/Long (circle or	ne): Conventional Survey,
86 Holland	Pood	USGS quad, Hand-held	GPS, Survey-grade GPS
			Twn 20N Rng 4W
Indianola,			
City Sta	ate Zip Code	Distance Direction 6 Miles North	Nearest Town of Indianola
Telephone No. ()		Miles NOT UI	ur THATAHOTS
		Data	· · · · · · · · · · · · · · · · · · ·
If flowing, method of flow regulation: Va	lve Other (describe)	6-14-06
Static Water Level: <u>35'</u> feet al Method of Measurement (circle one) (Hole depth: <u>122</u> Well de	bove (r below (circle one) teel tap electric tap pth: <u>122</u>	and surface Date measured:e air line other: _ Well grouted to a depth of	6-15-06
Static Water Level: <u>35'</u> feet al Method of Measurement (circle one) (Hole depth: <u>122</u> Well de Type of grout (circle one): Cement	bove er below (circle one) teel tape electric tap pth: <u>122</u> Bentonite Mix	and surface Date measured:e air line other: Well grouted to a depth of	6-15-06 10feet
Static Water Level: <u>35'</u> feet al Method of Measurement (circle one) (Hole depth: <u>122</u> Well de Type of grout (circle one): Cement Casing length: <u>82</u> feet Casin	bove or below (circle one) teel tape electric tape pth: <u>122</u> Bentonite Mix ng diameter: <u>16</u>	and surface Date measured:e air line other: Well grouted to a depth of	6-15-06
Static Water Level: $35'$ feet al Method of Measurement (circle one) (Hole depth: 122 Well de Type of grout (circle one): Cement Casing length: 82 feet Casin	bove er below (circle one) teel tape electric tap pth: <u>122</u> Bentonite Mix	and surface Date measured:e air line other: Well grouted to a depth of inches Type of casing:	6-15-06 10feet
Static Water Level: <u>35'</u> feet al Method of Measurement (circle one) (Hole depth: <u>122</u> Well de Type of grout (circle one): Cement Casing length: <u>82</u> feet Casin	bove r below (circle one) teel tape electric tape pth: <u>122</u> Bentonite Mix ng diameter: <u>16</u> en diameter: <u>16</u>	and surface Date measured:e air line other: Well grouted to a depth of inches Type of casing:	6-15-06 10feet PVC Sch.40 PVC Sch.40
Static Water Level: 35' feet al Method of Measurement (circle one) 6 Hole depth: 122 Well depth Type of grout (circle one): Cement Casing length: 82 feet Casin Screen length: 40 feet Scree Screen slot size: 050 inches	bove ir below (circle one) teel tape electric tape pth: <u>122</u> Bentonite Mix ng diameter: <u>16</u> sen diameter: <u>16</u> Setting depth: From	land surface Date measured: e air line other: _ Well grouted to a depth of inches Type of casing: _F inches Type of screen: 83 feet to1	6-15-06 <u>10</u> feet PVC Sch.40 PVC Sch.40 <u>22</u> feet
Static Water Level: 35' feet al Method of Measurement (circle one) 6 Hole depth: 122 Well depth Type of grout (circle one): Cement Casing length: 82 feet Casin Screen length: 40 feet Screen	bove or below (circle one) teel tape electric tape pth: <u>122</u> Bentonite Mix ng diameter: <u>16</u> sen diameter: <u>16</u> Setting depth: From <u>16</u> Gravel packed Under	land surface Date measured: e air line other: _ Well grouted to a depth of inches Type of casing: _F inches Type of screen: inches Type of screen: 83 feet to1 erreamed Telescoped Open	6-15-06 10feet PVC Sch.40 PVC Sch.40 22feet hole Natural Development
Static Water Level: 35' feet al Method of Measurement (circle one) 6 Hole depth: 122 Well deget Type of grout (circle one): Cement Casing length: 82 feet Casini Screen length: 40 feet Scree Screen slot size: 050 inches Type of completion (circle all applicable):	bove in below (circle one) teel tap: electric tap pth: <u>122</u> Bentonlite Mix ng diameter: <u>16</u> sen diameter: <u>16</u> Setting depth: From (ravel packed) Under Other (describe):	land surface Date measured: e air line other: _ Well grouted to a depth of inches Type of casing: _F inches Type of screen: 83 feet to1	6-15-06 10feet PVC Sch.40 PVC Sch.40 22feet hole Natural Development
Static Water Level: 35' feet al Method of Measurement (circle one) 6 Hole depth: 122 Well depth Type of grout (circle one): Cement Casing length: 82 feet Casin Screen length: 40 feet Scree Screen slot size: 050 inches	bove in below (circle one) teel tape electric tape pth: <u>122</u> Bentonite Mix ng diameter: <u>16</u> sen diameter: <u>16</u> Setting depth: From Gravel packed Under Other (describe):	land surface Date measured: e air line other: _ Well grouted to a depth of inches Type of casing: _F inches Type of screen: inches Type of screen: 83 feet to1 erreamed Telescoped Open	6-15-06 10feet PVC Sch.40 PVC Sch.40 22feet hole Natural Development
Static Water Level: <u>35</u> feet al Method of Measurement (circle one) Hole depth: <u>122</u> Well de Type of grout (circle one): Cement Casing length: <u>82</u> feet Casi: Screen length: <u>40</u> feet Scree Screen slot size: <u>050</u> inches Type of completion (circle all applicable):	bove in below (circle one) teel tap electric tap pth: <u>122</u> Bentonite Mix ng diameter: <u>16</u> sen diameter: <u>16</u> Setting depth: From (ravel packed) Under Other (describe):feet. If ta	and surface Date measured: e air line other: _ Well grouted to a depth of inches Type of casing: _F inches Type of screen: inches Type of screen:	6-15-06 10feet PVC Sch.40 PVC Sch.40 22feet hole Natural Development een, describe on back of page
Static Water Level: 35' feet al Method of Measurement (circle one) 6 Hole depth: 122 Well de Type of grout (circle one): Cement Casing length: 82 feet Casi: Screen length: 40 feet Scree Screen slot size: 050 inches Type of completion (circle all applicable): Top of lap pipe or reduction in casing:	bove in below (circle one) teel tap electric tap pth: <u>122</u> Bentonite Mix ng diameter: <u>16</u> sen diameter: <u>16</u> Setting depth: From (ravel packed) Under Other (describe):feet. If ta	and surface Date measured: e air line other: _ Well grouted to a depth of inches Type of casing: _F inches Type of screen: inches Type of screen:	6-15-06 10feet PVC Sch.40 PVC Sch.40 22feet hole Natural Development een, describe on back of page
Static Water Level: 35' feet al Method of Measurement (circle one) 6 Hole depth: 122 Well de Type of grout (circle one): Cement Casing length: 82 feet Casi: Screen length: 40 feet Scree Screen slot size: 050 inches Type of completion (circle all applicable): Top of lap pipe or reduction in casing:	bove in below (circle one) teel tap: electric tap pth: <u>122</u> Bentonite Mix ng diameter: <u>16</u> Setting depth: From (ravel packed) Under Other (describe): feet. If tap	and surface Date measured: e air line other: _ Well grouted to a depth of inches Type of casing: _F inches Type of screen: inches Type of screen: inches Type of screen: inches Type of screen:	6-15-06 10feet PVC Sch.40 PVC Sch.40 22feet hole Natural Development cen, describe on back of page Other:
Static Water Level: 35' feet al Method of Measurement (circle one) 6 Hole depth: 122 Well de Type of grout (circle one): Cement Casing length: 82 feet Casin Screen length: 40 feet Scree Screen slot size: 050 inches inches Type of completion (circle all applicable): No log ru Name of organization running log(s): I certify that the well was drilled, constr	bove or below (circle one) teel tape electric tape pth: <u>122</u> Bentonite Mix ng diameter: <u>16</u> sen diameter: <u>16</u> Setting depth: From (ravel packed) Unde Other (describe): feet. If to p Electric Gamma Ray	and surface Date measured: e air line other: _ Well grouted to a depth of inches Type of casing: _E inches Type of screen: inches Type of screen: inches Type of screen: inches Type of screen:	6-15-06 10 feet PVC Sch. 40 PVC Sch. 40 22 feet hole Natural Development cen, describe on back of page Other: requirements of the Mississip
Static Water Level: 35' feet all Method of Measurement (circle one) 6 Hole depth: 122 Well degree Type of grout (circle one): Cement Casing length: 82 feet Casini Screen length: 40 feet Scree Screen slot size: 050 inches Type of completion (circle all applicable): No log ru Name of organization running log(s): I certify that the well was drilled, constr Department of Environmental Quality a Irrigation Equipm	bove r belov (circle one) teel tap electric tap pth: <u>122</u> Bentonite Mix ng diameter: <u>16</u> setting depth: From ravel packed Unde Other (describe): feet. If ta p Electric Gamma Ray ucted, and completed in and/or the Mississippi De	and surface Date measured: e air line other: _ Well grouted to a depth of inches Type of casing: _E inches Type of screen: inches Type of screen: inches Type of screen: inches Type of screen:	6-15-06 10 feet PVC Sch. 40 PVC Sch. 40 22 feet hole Natural Development cen, describe on back of page Other: requirements of the Mississip
Static Water Level: 35' feet al Method of Measurement (circle one) 6 Hole depth: 122 Well de Type of grout (circle one): Cement Casing length: 82 feet Casi: Screen length: 40 feet Scree Screen slot size: 050 inches Type of completion (circle all applicable): No log ru Name of organization running log(s): I certify that the well was drilled, constr Department of Environmental Quality at	bove r belov (circle one) teel tap electric tap pth: <u>122</u> Bentonite Mix ng diameter: <u>16</u> setting depth: From ravel packed Unde Other (describe): feet. If ta p Electric Gamma Ray ucted, and completed in and/or the Mississippi De	and surface Date measured: e air line other: _ Well grouted to a depth of inches Type of casing: _E inches Type of screen: inches Type of screen: inches Type of screen: inches Type of screen:	6-15-06 10 feet PVC Sch. 40 PVC Sch. 40 22 feet hole Natural Development cen, describe on back of page Other: requirements of the Mississip

JUN 2 9 2006 BY: OLWR

ł

If well telescopes please sketch below and show depths.

Ground Level


.

.

Description of Formations Encountered	From To
	0 21
Clay Fine Sand Fine Sand/gravel Med. Sand/gravel	22 35
Fine Sand/gravel	36 45
Med. Sand/gravel	46122

K-

If more than one screen, show location of each on sketch

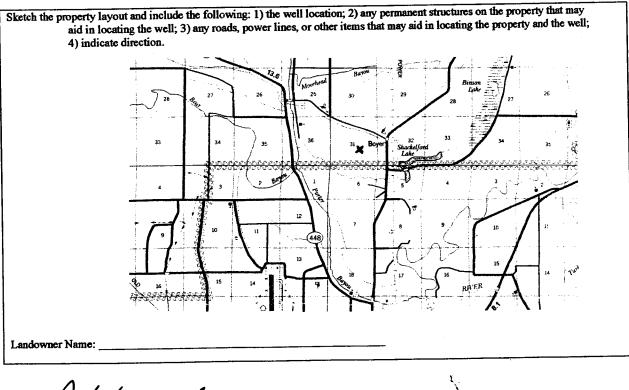

æ

Signature of Water Well Contractor

$\frac{\text{County:} \text{Sunflow}}{\text{Permit #: } \mathcal{O} \mathcal{U}}$	ower <u>41172</u> n Equipment	Fump Installer Mississippi Departme	ELL REPORT Part 2 Ps Completion Report ant of Environmental Quality and Water Resources	For Office Use Only: Aquifer:	
Date completed:	6-14-06	Jackson, (601	Box 10631 MS 39289-0631 1961-5210 54-6938 (fax)	Well #: <u>K-115</u> Elevation:	
	eport must be complete (ached and both parts)	uea win the Department		p installer. A copy of Part 1 of th 0 days of well completion.	
	Well Owner Inform	ation			
	londike Farm		Latitude:	Longitude:	
Mailing Address: c/o Perry Maloney			Method of Lat/Long (check one): Conventional Survey		
	86 Holland	Road	USGS quad, Hand-b	eld GPS, Survey-grade GPS_	
		<u>MS 3875</u> 1	¼¼ Sec_	<u>31 T20N R 4W</u>	
	City State	zip Code	Distance Directio	n Nearest Town	
Telephone No. ()		6 Miles North	1_of_Indianola	
	Ришр Турс			Power Type	
Circle one		Circle one			
Air Lift	Jet	Submersible	Diesel Engine Ga	soline Engine Natural C	
Bucket	Piston	Turbine	Electric Motor Ha	md Tractor P	
Centrifugal	Rotary	Flowing Well	Windmill Of	her (specify):	
Other (specify): _			Horse Power Rating of M	iotor:	
Date Pump Instal	ed:6-	15-06	Setting Depth:	70 feet	
		Gallons Per Minute	Number of Stages:		
	Pump Test Da	ta	Mcthod o	Measuring Water Level	
Date Well Tested	:		Alation Theorem	Measuring Line Steel Tap	
Static Water Level (A):Feet Below Land Surface					
		eet Below Land Surface	Other (specify):		
		eet Below Land Surface	For flowing well, measu	red shut in head:	
		Gallons Per Minute	Well yielded	GPM with a drawdown of	
		urs):hours	feet a	fterhours of pun	
			1		
			1 Charles	1	
	TIFY that the above sta k M. Chism		ST OT HIY KINOWIGAR	NV NV	

RECEIVED JUN 2 9 2006 BY: OLWR